

Pike
F47
10-6-71

MISSISSIPPI
BOARD OF WATER COMMISSIONERS
416 North State Street
Jackson, Mississippi 39201

WATER WELL DRILLERS LOG

CODED

10-6 date well completed 1971 firm name *Fitzgerald Well Dr* county well located *Pike*

LANDOWNER:	description of formations encountered	from	to
<i>Earl Ray Jackson</i>			
<i>R.R. Jones, miss.</i> (mailing address)	<i>Red sand</i>	<i>20</i>	<i>150</i>
	<i>Coarse sand</i>	<i>150</i>	<i>164</i>

WELL LOCATION:
sec. 5 T. 3 N. R. 9 E.
S W
8 miles E of 20160
(distance) (direction) (nearest town)

WELL PURPOSE: *Flow*
(home, irrigation, municipal, industrial)

- WELL COMPLETION DATA:
- (1) diameter (inches) 4
 - (2) total depth (feet) 164
 - (3) static water level (feet) 130 below above top of ground.
 - (4) casing plastic, 156
(material) (depth)
4 if telescope see back.
(size)
 - (5) screen 8, 156
(length) (depth to top)
4, plastic
(size) (material)
 - (6) pump 1/2, 6
(HP) (yield gpm)
Electric
(type power)
 - (7) electric log No
(yes or no)
(organization running log)
 - (8) how well bottom plugged wood plug

CODED


OCT 28 1971

DRILLERS REMARKS:

MISS. Bd. OF
WATER COMMISSIONERS

If well telescopes please sketch and show depths.

GROUND LEVEL

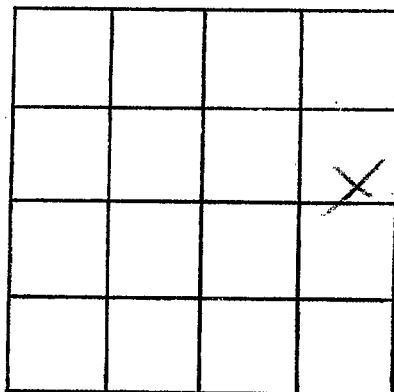

SECTION 5

Please indicate well location X.

ADDITIONAL INFORMATION

If more than one screen,
show locations of each on sketch.