

PIKE  
F 49  
11-15-71

MISSISSIPPI  
BOARD OF WATER COMMISSIONERS SEC 28 1971  
416 North State Street  
Jackson, Mississippi 39201

WATER WELL DRILLERS LOG

**CODED**

NOV 15 1971 *Chet Reese* *Pike*  
date well completed firm name county well located

LANDOWNER: *George Bullack*  
*Rt 3, Tylertown*  
(mailing address)

| description of formations encountered | from       | to         |
|---------------------------------------|------------|------------|
| <i>Red clay</i>                       | <i>0</i>   | <i>20</i>  |
| <i>Sandy clay</i>                     | <i>20</i>  | <i>42</i>  |
| <i>white chalk</i>                    | <i>42</i>  | <i>90</i>  |
| <i>blue chalk</i>                     | <i>90</i>  | <i>126</i> |
| <i>Coarse sand &amp; pea gravel</i>   | <i>126</i> | <i>140</i> |

WELL LOCATION:  
sec. *14* T. *3* N. R. *9* E  
*5 1/2* miles *S* *Bridal* -  
(distance) (direction) (nearest town)

WELL PURPOSE: *Home*  
(home, irrigation, municipal, industrial)

WELL COMPLETION DATA:  
(1) diameter (inches) *4"*  
(2) total depth (feet) *140*  
(3) static water level (feet) *80* *below* *above*  
top of ground.  
(4) casing *Plast. Bottom*  
(material) (depth)  
(size) If telescope see back.  
(5) screen *6'* *134'*  
(length) (depth to top)  
*4"* *Plast.*  
(size) (material)  
(6) pump *Bayanor*  
(HP) (yield gpm)  
(type power)  
(7) electric log *No*  
(yes or no)  
(organization running log)


**CODED**

(8) how well bottom plugged  
*wooden plug*

DRILLERS REMARKS:

If well telescopes please sketch and show depths.

GROUND LEVEL

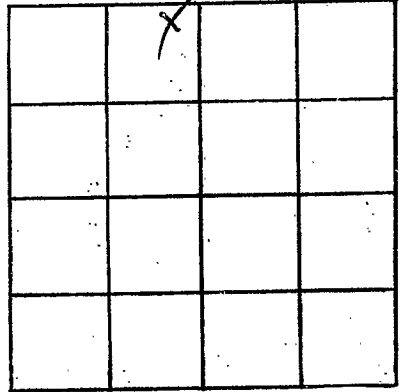

SECTION 114

Please indicate well location X.

ADDITIONAL INFORMATION

If more than one screen, show locations of each on sketch.