

Pike  
F 51  
3-7-72

MISSISSIPPI  
BOARD OF WATER COMMISSIONERS  
416 North State Street  
Jackson, Mississippi 39201

**CODED**

WATER WELL DRILLERS LOG

March 7 1972 Chester Keller Pike  
date well completed firm name county-well located

LANDOWNER: Lucian Smith  
Rt 1, Summit  
(mailing address)

description of formations encountered	from	to
Red sandy clay	0	18
yellow sand	18	61
gravel	61	96
chert sand	96	150
sand	150	158
Red gravel sand		

WELL LOCATION:  
sec. 4 T 3 N R 9 E  
8 1/2 miles E Mt. Laurel  
(distance) (direction) (nearest town)

WELL PURPOSE: Farm  
(home, irrigation, municipal, industrial)

WELL COMPLETION DATA:

- (1) diameter (inches) ~~10 1/2~~ 4"
- (2) total depth (feet) 158
- (3) static water level (feet) 109 below top of ground.
- (4) casing Plastic, galvanized  
(material) (depth)
- (size) if telescope see back.
- (5) screen 6' length, 152' depth to top  
1 1/2" size, Plastic material
- (6) pump 1/2 HP Sub-1 1/2 (yield gpm)  
Electric (type power)
- (7) electric log No (yes or no)

**CODED**


(organization running log)

(8) how well bottom plugged  
woodchuck

DRILLERS REMARKS:  
New house.

If well telescopes please sketch and show depths.

GROUND LEVEL

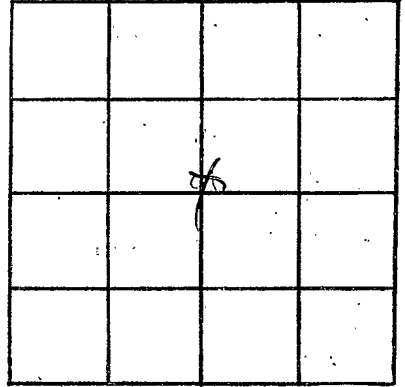

SECTION 4

Please indicate well location X.

ADDITIONAL INFORMATION

If more than one screen, show locations of each on sketch.