

Pike
F 52
7-31-72

MISSISSIPPI
BOARD OF WATER COMMISSIONERS
416 North State Street
Jackson, Mississippi 39201

WATER WELL DRILLERS LOG

CODED

31 July 1972 date well completed
J. J. Corporation firm name
county well located

LANDOWNER:	description of formations encountered	from	to
McComb Lumber Co	Clay	0	10
McComb - (mailing address)	Red Clay	10	25
	Chalk	25	35
	2nd shell	35	50
	Chalk	50	60
	3rd shell	60	85
	Chalk	85	135
	Sand	135	169

WELL LOCATION:
sec 23 T 3 N R 9 E
7 miles E of Halesville
(distance) (direction) (nearest town)

WELL PURPOSE:
(home, irrigation, municipal, industrial)

- WELL COMPLETION DATA:
- (1) diameter (inches) 4
 - (2) total depth (feet) 169
 - (3) static water level (feet) 85 below top of ground.
 - (4) casing PI 163
(material) (depth)
 - (size) if telescope see back.
 - (5) screen 6 163
(length) (depth to top)
 - (size) (material)
 - (6) pump 1/2 8
(HP) (yield gpm)
 - (type power)
 - (7) electric log (yes or no)
 - (organization running log)
 - (8) how well bottom plugged wood

CODED


001 - 5 1972

DRILLERS REMARKS:

MISSISSIPPI
BOARD OF WATER COMMISSIONERS

If well telescopes please sketch and show depths.

GROUND LEVEL

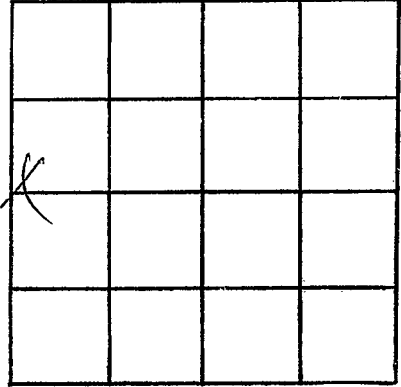

SECTION 23

Please indicate well location X.

ADDITIONAL INFORMATION

If more than one screen,
show locations of each on sketch.