

Pike

~~WALKER~~  
**F53**  
**9-72**

MISSISSIPPI  
 BOARD OF WATER COMMISSIONERS  
 416 North State Street  
 Jackson, Mississippi 39201

**CODED**

**WATER WELL DRILLERS LOG**

Pike

*Walker*

Sept. 1972 Dean Griner  
 date well completed firm name county well located

LANDOWNER: Pearl River Valley  
 Development,  
 Walkers Bridge Recreation  
 Area - Bogrechitto River  
 (mailing address)

description of formations encountered

from to

Top Soil

0 3

Sand + Gravel

3 42

Clay

42 55

Sand rocks + Sand

55 64

Clay

64 86

Clay

86 116

Sand, Fine

116 122

Sand

122 202

Sand, Coarse

202 230

WELL LOCATION:

34WA  
 sec T 3 N R 9 E  
 Hwy 98 + Bogrechitto River  
 miles of (distance) (direction) (nearest town)

WELL PURPOSE:

(home, irrigation, municipal, industrial)

WELL COMPLETION DATA:

6" 30'

(1) diameter (inches) 4

(2) total depth (feet) 930

(3) static water level (feet) 75' 10" below top of ground.

(4) casing B.I., 200' (material) (depth)

4 (size) If telescope see back.

(5) screen 30', 200' (length) (depth to top)

4, 304 SS - .012 (size) (material)

(6) pump No Pump (HP) (yield gpm)

(type power)

(7) electric log NO (yes or no)

NO (organization running log)

(8) how well bottom plugged Back Pressure Valley

DRILLERS REMARKS:

Cemented Casing


**CODED**

OCT 11 1972

MISS. BOARD OF WATER COMMISSIONERS

If well telescopes please sketch and show depths.

GROUND LEVEL

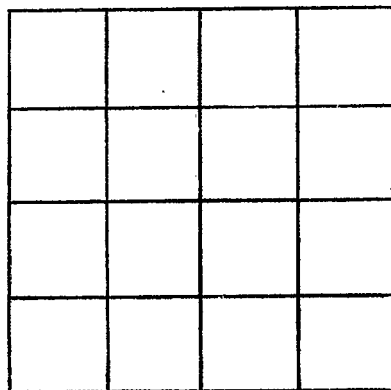

SECTION \_\_\_\_\_

Please indicate well location X.

ADDITIONAL INFORMATION

If more than one screen, show locations of each on sketch.