

Pike
F54
10-4-72

MISSISSIPPI
BOARD OF WATER COMMISSIONERS
416 North State Street
Jackson, Mississippi 39201

WATER WELL DRILLERS LOG

CODED

10-4 1972 Field firm name Pike county well located

LANDOWNER: Roy House
R.R. Johnson
(mailing address)

description of formations encountered	from	to
Red clay	0	70
White sand & gravel	10	50
White clay	50	110
Green sand & gravel	110	125

WELL LOCATION:
sec. 34 T. 3N R. 9E
9 miles E of McComb
(distance) (direction) (nearest town)

WELL PURPOSE: Home
(home, irrigation, municipal, industrial)

WELL COMPLETION DATA:

(1) diameter (inches) 4

(2) total depth (feet) 123

(3) static water level (feet) 6 below above top of ground.

(4) casing plastic 115
(material) (depth)
4 if telescope see back.
(size)

(5) screen 8 115
(length) (depth to top)
4 plastic
(size) (material)

(6) pump 1 30
(HP) (yield gpm)
Gas
(type power)

(7) electric log no
(yes or no)
no
(organization running log)

(8) how well bottom plugged closed

CODED


OCT 17 1972

DRILLERS REMARKS:

MISS. ED. 6
WATER 001

If well telescopes please sketch and show depths.

GROUND LEVEL

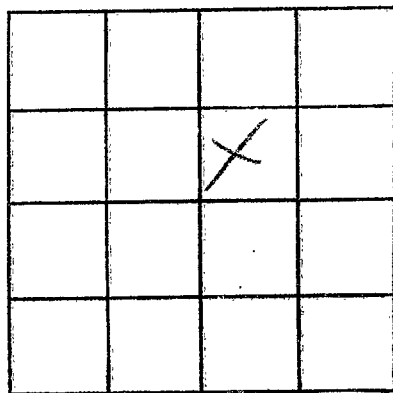

SECTION 34

Please indicate well location X.

ADDITIONAL INFORMATION

If more than one screen, show locations of each on sketch.