

PIKE
~~WALTHALL~~
F 55
7-25-72

MISSISSIPPI
 BOARD OF WATER COMMISSIONERS
 416 North State Street
 Jackson, Mississippi 39201

CODED

WATER WELL DRILLERS LOG

July 25 19 72 Fitzgerald Pike
 date well completed firm name county well located

LANDOWNER:
West Mt. Olive Church
R.R. Gylbertson, Minn.
 (mailing address)

description of formations encountered	from	to
Red Clay	0	20
Red Sand	20	75
Blue Clay	75	160
Coarse Sand	160	174

WELL LOCATION:
 sec. 33 T 3 N R 9 E
9 miles W of Fitzgerald
 (distance) (direction) (nearest town)

WELL PURPOSE: Home
 (home, irrigation, municipal, industrial)

CODED

- WELL COMPLETION DATA:**
- (1) diameter (inches) 4
 - (2) total depth (feet) 174
 - (3) static water level (feet) 90 below above top of ground.
 - (4) casing Plastic, 166
 (material) (depth)
4 If telescope see back.
 (size)
 - (5) screen 8, 166
 (length) (depth to top)
4, Plastic
 (size) (material)
 - (6) pump 1/2, 10
 (HP) (yield gpm)
Electric
 (type power)
 - (7) electric log no
 (yes or no)
Wood peg
 (organization running log)
 - (8) how well bottom plugged Wood peg


DRILLERS REMARKS:

SEP 1 1972

MISS. BD. OF
 WATER COMM.

If well telescopes please sketch and show depths.

GROUND LEVEL

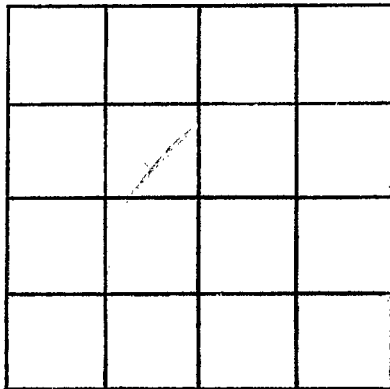

SECTION 3

Please indicate well location X.

ADDITIONAL INFORMATION

If more than one screen, show locations of each on sketch.