

Pike  
F57  
8-31-72

MISSISSIPPI  
BOARD OF WATER COMMISSIONERS  
416 North State Street  
Jackson, Mississippi 39201

WATER WELL DRILLERS LOG

CODED

Aug 31 1972 date well completed  
Chester Reems firm name  
Pike county well located

LANDOWNER: Robert C. Smith  
43 Tylerdown (mailing address)

| description of formations encountered | from to |     |
|---------------------------------------|---------|-----|
|                                       |         |     |
| red clay                              | 0       | 14  |
| red sand                              | 14      | 38  |
| sand & gravel                         | 38      | 43  |
| blue & white shell                    | 43      | 102 |
| fine blue sand                        | 102     | 112 |
| coarse sand & pea gravel              | 112     | 141 |

WELL LOCATION:  
sec. 11 T 3 N R 9 E  
10 miles E of Mendenhall (distance) (direction) (nearest town)

WELL PURPOSE: Domestic (home, irrigation, municipal, industrial)

WELL COMPLETION DATA:

- (1) diameter (inches) 11"
- (2) total depth (feet) 141
- (3) static water level (feet) 97 below top of ground.
- (4) casing Plastic bottom (material) (depth)
- (5) screen 6' length, 135' depth to top, 1/2" Plast (size) (material)
- (6) pump 1/2 HP, 12 yield gpm, Elect (type power)
- (7) electric log NO (yes or no)

CODED

(organization running log)


(8) how well bottom plugged wooden plug

DRILLERS REMARKS: New house

DEC 7 1972

If well telescopes please sketch and show depths.

GROUND LEVEL

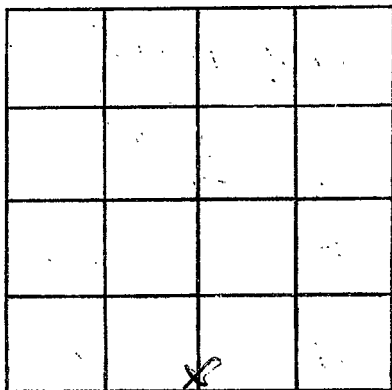

SECTION 11

Please indicate well location X.

ADDITIONAL INFORMATION

If more than one screen, show locations of each on sketch.