

MISSISSIPPI
BOARD OF WATER COMMISSIONERS
416 North State Street
Jackson, Mississippi 39201

CODED

WATER WELL DRILLERS LOG

Pike
F 59
11-8-72

Nov 6 1972 date well completed
Cherles Keener firm name
Pete county well located

LANDOWNER: W. A. Walker
Rt 2
McComb
(mailing address)

description of formations encountered	from	to
clay	0	19
white sand	19	40
sand gravel	40	58
white chalk	58	105
Regravel sand	105	133

WELL LOCATION:
sec. 31 T 3 N R 9 E
8 miles SE McComb
(distance) (direction) (nearest town)

WELL PURPOSE: Laundry
(home, irrigation, municipal, industrial)

- WELL COMPLETION DATA:
- (1) diameter (inches) 4"
 - (2) total depth (feet) 133
 - (3) static water level (feet) 15 below top of ground
 - (4) casing Plast bottom
(material) (depth)
 - (5) screen 6 127
(length) (depth to top)
4" Plast
(size) (material)
 - (6) pump 3/4 Sub 15
(HP) (yield gpm)
elect
(type power)
 - (7) electric log no
(yes or no)

CODED

(organization running log)

(8) how well bottom plugged
wooden plug


DRILLERS REMARKS:
New location

MAR 10 1972
MAR 10 1972

DIV. OF
WATER CONTROL

If well telescopes please sketch and show depths.

GROUND LEVEL

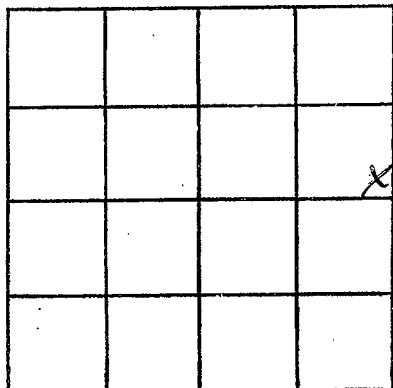

SECTION 31

Please indicate well location X.

ADDITIONAL INFORMATION

If more than one screen,
show locations of each on sketch.