

MISSISSIPPI
BOARD OF WATER COMMISSIONERS
416 North State Street
Jackson, Mississippi 39201

CODED

WATER WELL DRILLERS LOG

Pike
F 60
12-14-72

Dec 14 1972 date well completed
Chester Reeves firm name
Pike county well located

LANDOWNER: James Dutton

description of formations encountered

from to

Rt 3, Tylertown (mailing address)

red clay gravel	0	17
red sand clay gravel	17	127
white blue chalk	62	119
fine blue sand	119	154
coarse sand	154	170

WELL LOCATION:

sec. 14 T 3 N R. 9 E
4 1/2 miles (distance) SE (direction) of Harrell (nearest town)

WELL PURPOSE: Home
(home, irrigation, municipal, industrial)

WELL COMPLETION DATA:

- (1) diameter (inches) 14"
- (2) total depth (feet) 170
- (3) static water level (feet) 117 below top of ground.
- (4) casing Plast Ballast (material) (depth)
- (size) if telescope see back.
- (5) screen 6" (length) 164' (depth to top)
- 14" (size) Plast (material)
- (6) pump (HP) (yield gpm)
- (type power)
- (7) electric log no (yes or no)

(organization running log)

(8) how well bottom plugged
wooden plug

DRILLERS REMARKS:


New house

CODED

APP 2

If well telescopes please sketch and show depths.

GROUND LEVEL

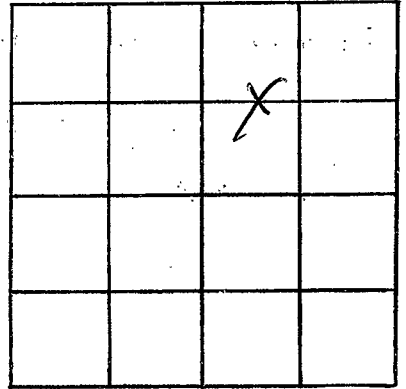

SECTION 14

Please indicate well location X.

ADDITIONAL INFORMATION

If more than one screen,
show locations of each on sketch.