

Pike  
F61  
6-16-73

MISSISSIPPI  
BOARD OF WATER COMMISSIONERS  
416 North State Street  
Jackson, Mississippi 39201

**CODED**

WATER WELL DRILLERS LOG

6-16 19 23 Fitzgerald Well Serv Pike  
date well completed firm name county well located

LANDOWNER:  
Fred Miller  
Robt M. Carls, Jr.  
(mailing address)

description of formations encountered	from	to
<u>Red clay</u>	<u>0</u>	<u>20</u>
<u>Red sand</u>	<u>20</u>	<u>100</u>
<u>Red gravel</u>	<u>100</u>	<u>110</u>
<u>Red sand</u>	<u>110</u>	<u>130</u>
<u>Coarse sand &amp; gravel</u>	<u>130</u>	<u>144</u>

WELL LOCATION:  
sec. 9 T. 30 N. R. 9 E  
8 miles SSW of Pinola  
(distance) (direction) (nearest town)

WELL PURPOSE: Home  
(home, irrigation, municipal, industrial)

- WELL COMPLETION DATA:
- (1) diameter (inches) 4
  - (2) total depth (feet) 144
  - (3) static water level (feet) 80 below above top of ground.
  - (4) casing galv 136  
(material) (depth)  
4 if telescope see back.  
(size)
  - (5) screen 8 136  
(length) (depth to top)  
4 plastic  
(size) (material)
  - (6) pump 1/2 10  
(HP) (yield gpm)  
elec  
(type power)
  - (7) electric log no  
(yes or no)  
(organization running log)
  - (8) how well bottom plugged wood plug


**CODED**

DRILLERS REMARKS:

JUN 29 1973

If well telescopes please sketch and show depths.

GROUND LEVEL

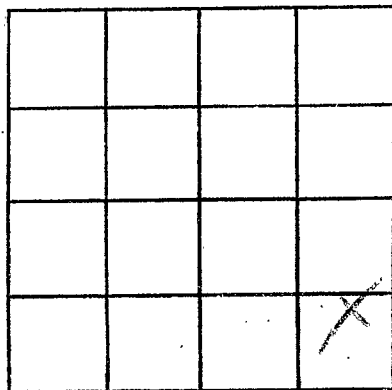

SECTION 9

Please indicate well location X.

ADDITIONAL INFORMATION

If more than one screen, show locations of each on sketch.