

Pike
F 62
5-18-73

MISSISSIPPI
BOARD OF WATER COMMISSIONERS
416 North State Street
Jackson, Mississippi 39201

CODED

WATER WELL DRILLERS LOG

5-18 19 73 Fitzgerald Well Serv Pike
date well completed firm name county well located

LANDOWNER:
Waver Bains
R.R. Summit Miss.
(mailing address)
WELL LOCATION:
sec. 11 T. 3N R. 9E
5 miles S of Pike
(distance) (direction) (nearest town)

description of formations encountered	from	to
<u>red clay</u>	<u>0</u>	<u>20</u>
<u>red sand</u>	<u>20</u>	<u>90</u>
<u>whitest red clay</u>	<u>90</u>	<u>135</u>
<u>fine sand</u>	<u>135</u>	<u>140</u>
<u>course sand</u>	<u>140</u>	<u>158</u>

WELL PURPOSE:
(home, irrigation, municipal, industrial)

WELL COMPLETION DATA:
(1) diameter (inches) 4
(2) total depth (feet) 158
(3) static water level (feet) 120 below top of ground.
(4) casing plastic, 150,
(material) (depth)
4 if telescope see back.
(size)
(5) screen 8, 150
(length) (depth to top)
4, plastic
(size) (material)
(6) pump 1/2, 10
(HP) (yield gpm)
Electric
(type power)
(7) electric log no
(yes or no)
(organization running log)
(8) how well bottom plugged comple


CODED

DRILLERS REMARKS:

JUN 20 1973

If well telescopes please sketch and show depths.

GROUND LEVEL

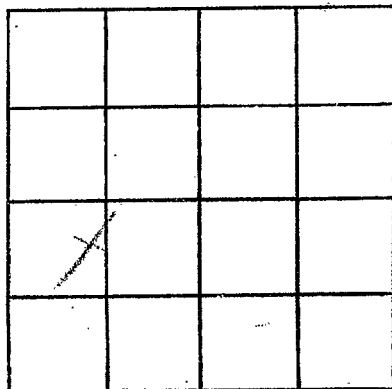

SECTION

Please indicate well location X.

ADDITIONAL INFORMATION

If more than one screen, show locations of each on sketch.