

F 63  
 PIKE  
 5-28-73

MISSISSIPPI  
 BOARD OF WATER COMMISSIONERS  
 416 North State Street  
 Jackson, Mississippi 39201

**CODED**

WATER WELL DRILLERS LOG

May 28 1973 Chatterbeus Pike  
 date well completed firm name county well located

LANDOWNER Eddie Smith  
Rt 3 Tyler town  
 (mailing address)

WELL LOCATION:  
 sec. 4 T 3 N R 9 E  
3 1/2 miles S of Boicehall  
 (distance) (direction) (nearest town)

WELL PURPOSE: Home  
 (home, irrigation, municipal, industrial)

- WELL COMPLETION DATA:
- (1) diameter (inches) 4"
  - (2) total depth (feet) 149
  - (3) static water level (feet) 90 below top of ground.
  - (4) casing Plast. Ballton  
 (material) (depth)
  - (size) if telescope see back.
  - (5) screen 6' 143'  
 (length) (depth to top)
  - 16" Plast  
 (size) (material)
  - (6) pump 1/2 Sub 19  
 (HP) (yield gpm)
  - Electric  
 (type power)
  - (7) electric log no  
 (yes or no)
  - (organization running log)
  - (8) how well bottom plugged  
wooden plug


description of formations encountered	from	to
Clay	0	17
Red Sand	17	38
Sand & Gravel	38	52
White Chalk	52	68
Red gravel & Sand	68	79
Subsilty sand	79	131
Medium Sand	131	149

DRILLERS REMARKS:  
New hole

AUG 20 1973

If well telescopes please sketch and show depths.

GROUND LEVEL

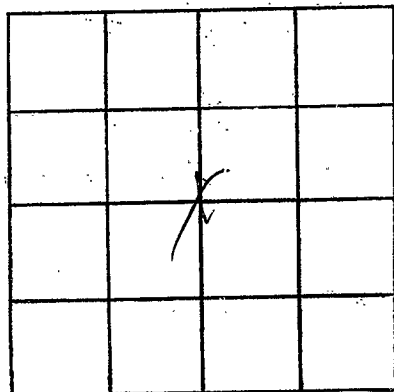

SECTION 11

Please indicate well location X.

ADDITIONAL INFORMATION

If more than one screen, show locations of each on sketch.