

F 64
PIKE
7-11-73

MISSISSIPPI
BOARD OF WATER COMMISSIONERS
416 North State Street
Jackson, Mississippi 39201

CODED

WATER WELL DRILLERS LOG

July 11 1973 date well completed
Chester Keener firm name
Kibos county well located

LANDOWNER: William
Roberts
P.O. Summit
(mailing address)

description of formations encountered	from	to
Clay	0	16
Sand & gravel	16	56
Subsally Sand	96	105
Mixed Chalk & gravel	105	118
chalk	118	122
Coarse Sand	122	134

WELL LOCATION:
sec 28 T 4 N R 9 E
1 miles SSW Piccadilly
(distance) (direction) (nearest town)

WELL PURPOSE: Farm
(home, irrigation, municipal, industrial)

- WELL COMPLETION DATA:
- (1) diameter (inches) 4"
 - (2) total depth (feet) 134
 - (3) static water level (feet) 90 below above top of ground.
 - (4) casing Plast. Bottom
(material) (depth)
 - _____ if telescope see back.
(size)
 - (5) screen 6' 128'
(length) (depth to top)
 - cell Plast
(size) (material)
 - (6) pump Agawyer
(HP) (yield gpm)
 - _____ (type power)
 - (7) electric log NO
(yes or no)
 - _____ (organization running log)

CODED


(8) how well bottom lugged
wooden plug

DRILLERS REMARKS:
old 2" well hole

AUG 20 1973

If well telescopes please sketch and show depths.

GROUND LEVEL

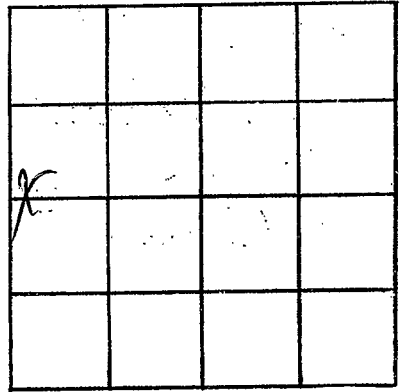

SECTION 28

Please indicate well location X.

ADDITIONAL INFORMATION

If more than one screen, show locations of each on sketch.