

F 65
 PIKE
 7-13-73

MISSISSIPPI
 BOARD OF WATER COMMISSIONERS
 416 North State Street
 Jackson, Mississippi 39201

CODED

WATER WELL DRILLERS LOG

July 13 1973 Chester Leves Pike
 date well completed firm name county well located

LANDOWNER Mrs. Betty Jo Creel
H. Z. McCamb
 (mailing address)

WELL LOCATION:
 sec 30 T 3 N R 9 E
7 miles SE of McCamb
 (distance) (direction) (nearest town)

WELL PURPOSE: Household
 (home, irrigation, municipal, industrial)

- WELL COMPLETION DATA:
- (1) diameter (inches) 4"
 - (2) total depth (feet) 130
 - (3) static water level (feet) 100 below top of ground.
 - (4) casing Plast. Ballston
 (material) (depth)
 - _____ If telescope see back.
 (size)
 - (5) screen 6' 124
 (length) (depth to top)
 - 4" Plast
 (size) (material)
 - (6) pump 1/2 Sub 12
 (HP) (yield gpm)
 - elect
 (type power)
 - (7) electric log no
 (yes or no)
 - _____ (organization running log)

description of formations encountered	from	to
Red Clay	0	17
Red Sands	17	62
Red Chalk	62	90
Sand & gravel	90	95
White Chalk	95	103
Small gravel & sand	103	130


CODED

(8) how well bottom plugged was plugged
 DRILLERS REMARKS: all 2" well had

AUG 20 1973

If well telescopes please sketch and show depths.

GROUND LEVEL

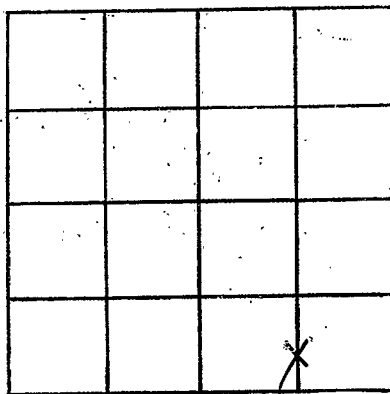

SECTION 30

Please indicate well location X.

ADDITIONAL INFORMATION

If more than one screen, show locations of each on sketch.