

PIKE
F 66
10-17-73

MISSISSIPPI
BOARD OF WATER COMMISSIONERS
416 North State Street
Jackson, Mississippi 39201

WATER WELL DRILLERS LOG

CODED

Oct 17 1973 *Chester Keener* *Rite*
date well completed firm name county well located

LANDOWNER: *Robert Fuller*
Rt 2, McComb
(mailing address)

| description of formations encountered | from | to |
|---------------------------------------|-----------|-----------|
| <i>Sandy clay</i> | <i>0</i> | <i>12</i> |
| <i>white chalk</i> | <i>12</i> | <i>18</i> |
| <i>Sand & gravel</i> | <i>18</i> | <i>27</i> |
| <i>Slightly</i> | <i>27</i> | <i>52</i> |
| <i>Coarse Sand</i> | <i>52</i> | <i>65</i> |
| <i>Reagravel & Sand</i> | <i>65</i> | <i>75</i> |

WELL LOCATION:
sec. *20* T. *3* N R. *9* E
at Holmsville of
(distance) (direction) (nearest town)

WELL PURPOSE: *Home*
(home, irrigation, municipal, industrial)

WELL COMPLETION DATA:

(1) diameter (inches) *1 1/2"*

(2) total depth (feet) *75*

(3) static water level (feet) *15* below above top of ground.

(4) casing *Plast Bottom*
(material) (depth)

_____ if telescope see back.
(size)

(5) screen *6'* *69'*
(length) (depth to top)

4" *Plast*
(size) (material)

(6) pump *swersed pump*
(HP) (yield gpm)

_____ (type power)

(7) electric log *NO*
(yes or no)

_____ (organization running log)

(8) how well bottom plugged *wooden plug*


CODED

DRILLERS REMARKS: *old well pumped sand*

NOV 7 1973
Miss. Bd. of Water Comm.

If well telescopes please sketch and show depths.

GROUND LEVEL

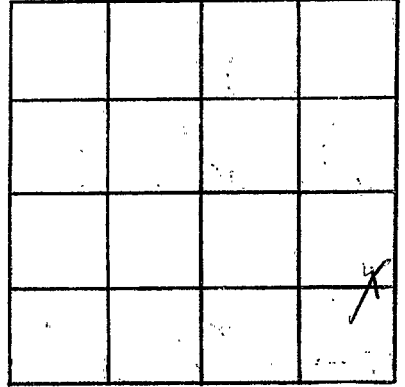

SECTION 20

Please indicate well location X.

ADDITIONAL INFORMATION

If more than one screen,
show locations of each on sketch.