

PIKE
F 67
10-3-73

MISSISSIPPI
BOARD OF WATER COMMISSIONERS
416 North State Street
Jackson, Mississippi 39201

CODED

WATER WELL DRILLERS LOG

10-3 date well completed 19 73 firm name *Fitzgerald Well Service - Pike* county well located

LANDOWNER:

R. J. Colatta

description of formations encountered

from

to

R. R. McComb Miss.
(mailing address)

<i>Red Clay</i>	0	20
<i>Red Sand</i>	20	80
<i>Blue Clay</i>	80	160
<i>Coarse Sand</i>	160	182

WELL LOCATION:

sec. 33 T 3 N R 9 E
S W
9 miles E of *McComb*
(distance) (direction) (nearest town)

WELL PURPOSE: *Home*
(home, irrigation, municipal, industrial)

WELL COMPLETION DATA:

- (1) diameter (inches) 4
- (2) total depth (feet) 182
- (3) static water level (feet) 120 below top of ground.
- (4) casing plastic, 174,
(material) (depth)
4 If telescope see back.
(size)
- (5) screen 8, 174
(length) (depth to top)
4, plastic
(size) (material)
- (6) pump 1/2, 10
(HP) (yield gpm)
ebu
(type power)
- (7) electric log yes
(yes or no)
(organization running log)
- (8) how well bottom plugged wood plug

CODED


NOV 15 1973

DRILLERS REMARKS:

MISS. BO. OF
WATER COMMISSIONERS

If well telescopes please sketch and show depths.

GROUND LEVEL

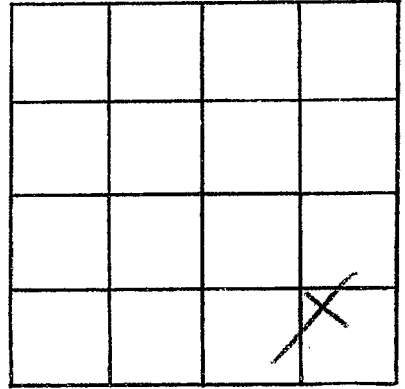

SECTION 33

Please indicate well location X.

ADDITIONAL INFORMATION

If more than one screen,
show locations of each on sketch.