

PIKE
F69
12-12-73

MISSISSIPPI
BOARD OF WATER COMMISSIONERS CODED
416 North State Street
Jackson, Mississippi 39201

WATER WELL DRILLERS LOG

12 Dec 1973 *Amor Petroleum* *Pike*
date well completed firm name county well located

LANDOWNER:
David Gibson
Summit
(mailing address)

WELL LOCATION:
sec. 16 T 3 N R 9 E
4 miles N of Hidawayville
(distance) (direction) (nearest town)

description of formations encountered	from	to
<i>clay</i>	<i>0</i>	<i>20</i>
<i>chert</i>	<i>20</i>	<i>35</i>
<i>red chert</i>	<i>35</i>	<i>50</i>
<i>rod</i>	<i>50</i>	<i>73</i>

WELL PURPOSE:
(home, irrigation, municipal, industrial)

WELL COMPLETION DATA:

(1) diameter (inches) 4

(2) total depth (feet) 73

(3) static water level (feet) 50 below above top of ground.

(4) casing 11, 6.7,
(material) (depth)
(size) if telescope see back.

(5) screen 6, 6.7
(length) (depth to top)
4, 11
(size) (material)

(6) pump 1/2, 8
(HP) (yield gpm)
elct
(type power)

(7) electric log _____
(yes or no)
(organization running log)

(8) how well bottom plugged wood


CODED

MISSISSIPPI BOARD OF WATER COMMISSIONERS
FEB 14 1974

DRILLERS REMARKS:

If well telescopes please sketch and show depths.

GROUND LEVEL

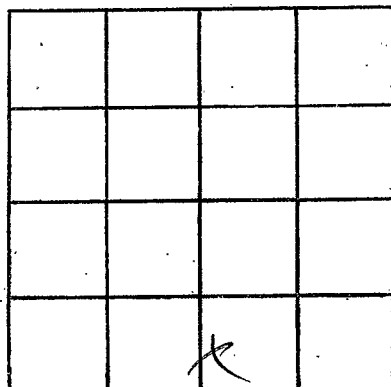

SECTION 16

Please indicate well location X.

ADDITIONAL INFORMATION

If more than one screen, show locations of each on sketch.