

PIKE  
F70  
4-29-74

MISSISSIPPI  
BOARD OF WATER COMMISSIONERS  
416 North State Street  
Jackson, Mississippi 39201 **CODED**

WATER WELL DRILLERS LOG

29 April 1974 J.T. Colington & Son Pike  
date well completed firm name county well located

LANDOWNER:  
Bob Burrows  
M. Cantel  
(mailing address)


description of formations encountered	from	to
clay	0	10
shale	10	25
clay	25	45
sand	45	94

WELL LOCATION:  
sec. 3 T. 3 N. R. 9 E  
3 miles S Grubbs  
(distance) (direction) (nearest town)

WELL PURPOSE:  
(home, irrigation, municipal, industrial)

- WELL COMPLETION DATA:
- (1) diameter (inches) 4
  - (2) total depth (feet) 94
  - (3) static water level (feet) 50 below top of ground.
  - (4) casing 11 88 (material) (depth)
  - (size) if telescope see back.
  - (5) screen 6 88 (length) (depth to top)
  - 4 (size) (material)
  - (6) pump 8 8 (HP) (yield gpm)
  - elect (type power)
  - (7) electric log (yes or no)
  - (organization running log)
  - (8) how well bottom plugged Wood

**CODED**

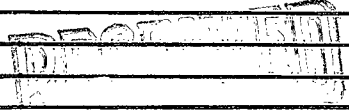


MAY 1 1974

MISS. Bd. OF WATER COMMISSIONERS

DRILLERS REMARKS:

If well telescopes please sketch and show depths.

GROUND LEVEL

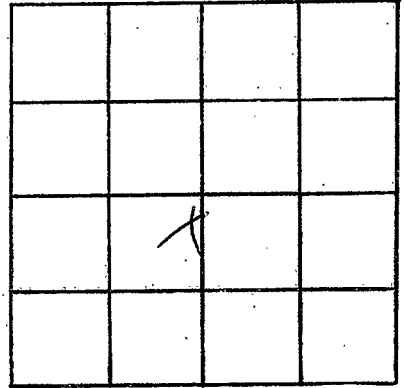

SECTION 3

Please indicate well location X.

ADDITIONAL INFORMATION

If more than one screen, show locations of each on sketch.