

PIKE
F71

2-27-74

MISSISSIPPI
BOARD OF WATER COMMISSIONERS
416 North State Street
Jackson, Mississippi 39201

CODED

WATER WELL DRILLERS LOG

2-27

date well completed

19

24 Fitzgerald Well Serv

firm name

Pike

county well located

LANDOWNER:

J. Frank Smith
R.R. Summit
(mailing address)

description of formations
encountered

from

to

Red Clay	0	15
Red gravel	15	25
Red sand	25	65
Coarse sand + gravel	65	88

WELL LOCATION:

sec. 21 T. 3 N R. 7 E
2 miles E of Holmsville
(distance) (direction) (nearest town)

WELL PURPOSE: Home
(home, irrigation, municipal, industrial)

WELL COMPLETION DATA:

- (1) diameter (inches) 4
- (2) total depth (feet) 88
- (3) static water level (feet) 20 below top of ground.
- (4) casing: plastic, 80 (material) (depth)
4 (size) if telescope see back.
- (5) screen: 8 (length) 80 (depth to top)
4 (size) plastic (material)
- (6) pump: 1/2 (HP) 14 (yield gpm)
elec (type power)
- (7) electric log no (yes or no)
- (8) how well bottom plugged: Seal block

CODED

DECEMBER 1974


MAY 26 1974

MISS. BOARD OF WATER COMMISSIONERS

DRILLERS REMARKS:

If well telescopes please sketch and show depths.

GROUND LEVEL

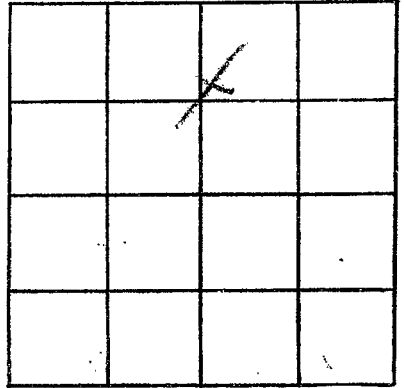

SECTION 21

Please indicate well location X.

ADDITIONAL INFORMATION

If more than one screen,
show locations of each on sketch.