

PIKE
F 72
4-17-74

MISSISSIPPI
BOARD OF WATER COMMISSIONERS
416 North State Street
Jackson, Mississippi 39201

WATER WELL DRILLERS LOG

CODED

4-17
date well completed

1974 *Fitzgerald and Son*
firm name

Pike
county well located

LANDOWNER:

Pauline Dillon

RR Summit Miss.
(mailing address)

description of formations encountered

from to

<i>Red Clay</i>	<i>0</i>	<i>20</i>
<i>Red Sand</i>	<i>20</i>	<i>120</i>
<i>Red Chalk</i>	<i>120</i>	<i>160</i>
<i>Coarse Sand</i>	<i>160</i>	<i>175</i>

WELL LOCATION:

sec. *4* T. *3* (N) R. *9* (E)
3 miles *SW* of *Prichard*
(distance) (direction) (nearest town)

WELL PURPOSE: *Home*
(home, irrigation, municipal, industrial)

WELL COMPLETION DATA:

- (1) diameter (inches) *4*
- (2) total depth (feet) *176*
- (3) static water level (feet) *110* below above top of ground.
- (4) casing *plastic*, *167*,
(material) (depth)
4 if telescope see back.
(size)
- (5) screen *8*, *167*
(length) (depth to top)
4, *plastic*
(size) (material)
- (6) pump *1/2*, *10*
(HP) (yield gpm)
elm
(type power)
- (7) electric log *no*
(yes or no)
- (organization running log)
- (8) how well bottom plugged *Sal. thick*

CODED


DRILLERS REMARKS:

MAY 16 1974

MISS. BO. OF WATER COMMISSIONERS

If well telescopes please sketch and show depths.

GROUND LEVEL

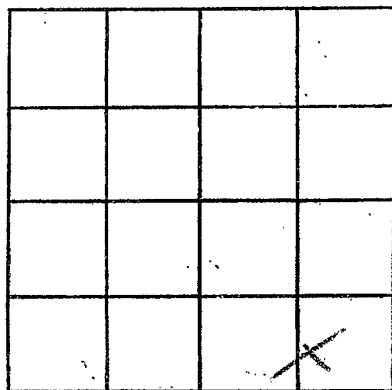

SECTION 4

Please indicate well location X.

ADDITIONAL INFORMATION

If more than one screen, show locations of each on sketch.