

PIKE
F 73
1-15-74

MISSISSIPPI
BOARD OF WATER COMMISSIONERS
416 North State Street
Jackson, Mississippi 39201

CODED

WATER WELL DRILLERS LOG

Jan 15 1974 Chester Keene P. Cho
date well completed firm name county well located

LANDOWNER: Willie
Montgomery
Rt 1, Summit
(mailing address)

description of formations encountered	from	to
Red clay	0	18
Red sand	18	7.5
Sand & gravel	7.5	105
Sand & chalk	105	140
Lean gravel & sand	140	158

WELL LOCATION:
sec 4 T 3 N R 9 E
2 1/2 miles SSE of Pinedale
(distance) (direction) (nearest town)

WELL PURPOSE: house
(home, irrigation, municipal, industrial)

- WELL COMPLETION DATA:
- (1) diameter (inches) 4"
 - (2) total depth (feet) 158
 - (3) static water level (feet) 100 below top of ground
 - (4) casing Plast Bottom
(material) (depth)
 - (size) If telescope see back.
 - (5) screen 6' 157'
(length) (depth to top)
 - 4" Plast
(size) (material)
 - (6) pump 1/2 hp 10
(HP) (yield gpm)
 - Elect
(type power)
 - (7) electric log NO
(yes or no)
 - (organization running log)

CODED


(8) how well bottom plugged
wooden plug

DRILLERS REMARKS:
New well

MAY 6 1974

If well telescopes please sketch and show depths.

GROUND LEVEL

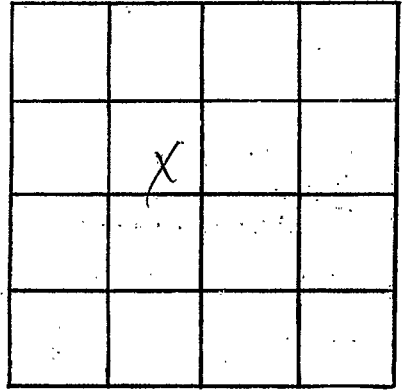

SECTION 4

Please indicate well location X.

ADDITIONAL INFORMATION

If more than one screen, show locations of each on sketch.