

PIKE
F 77
9/11/74

MISSISSIPPI
BOARD OF WATER COMMISSIONERS
416 North State Street
Jackson, Mississippi 39201

CODED


WATER WELL DRILLERS LOG

9-11 1974 Fitzgerald Well Service Rebe
date well completed firm name county well located

LANDOWNER:	description of formations encountered	from	to
<u>Jim Latum</u> <u>P.O. 2746, Miss.</u> (mailing address)	<u>Red clay</u> <u>Red sand & chert</u> <u>Orange sand</u>	<u>0</u> <u>20</u> <u>80</u>	<u>20</u> <u>80</u> <u>95</u>
WELL LOCATION: sec. <u>22</u> T. <u>3</u> N R. <u>9</u> E <u>2</u> miles <u>E</u> of <u>Holmesville</u> (distance) (direction) (nearest town)			
WELL PURPOSE: (home, irrigation, municipal, industrial) <u>Home</u>	CODED		
WELL COMPLETION DATA: (1) diameter (inches) <u>4</u> (2) total depth (feet) <u>95</u> (3) static water level (feet) <u>55</u> below above top of ground. (4) casing <u>plastic, 87</u> , (material) (depth) <u>4</u> if telescope see back. (size) (5) screen <u>8</u> , <u>87</u> (length) (depth to top) <u>4</u> , <u>plastic</u> (size) (material) (6) pump <u>1/2</u> <u>10</u> (HP) (yield gpm) <u>elec</u> (type power) (7) electric log <u>no</u> (yes or no) (organization running log) (8) how well bottom plugged <u>Sand shell</u>			
DRILLERS REMARKS:			

If well telescopes please sketch and show depths.

GROUND LEVEL

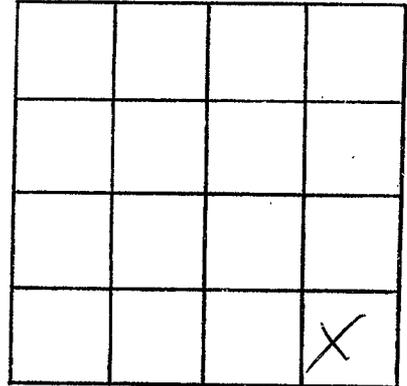

SECTION 22

Please indicate well location X.

ADDITIONAL INFORMATION

If more than one screen,
show locations of each on sketch.