

PIKE
F75
3-27-74

MISSISSIPPI
BOARD OF WATER COMMISSIONERS
416 North State Street
Jackson, Mississippi 39201

CODED

WATER WELL DRILLERS LOG

March 27 1974 Chesterville - Pita
date well completed firm name county well located


LANDOWNER:	description of formations encountered	from	to
Holmesville Recreation Center -	Sandy clay	0	16
Rt 2, McComb -	Sand gravel	16	38
(mailing address)	loam clay	38	74
WELL LOCATION:	Consolidated	74	90
sec. 21 T 3 N R 9 E			
in Holmesville			
WELL PURPOSE: domestic			
(home, irrigation, municipal, industrial)			
WELL COMPLETION DATA:			
(1) diameter (inches) 4"			
(2) total depth (feet) 90			
(3) static water level (feet) 25 below top of ground			
(4) casing (material) (depth)			
Plast. Bottom			
(size) If telescope see back.			
(5) screen (length) (depth to top)			
16' 94'			
(size) (material)			
(6) pump (HP) (yield gpm)			
14' Plast			
By others -			
(type power)			
(7) electric log (yes or no)			
NO -			
(organization running log)			
(8) how well bottom plugged			
wooden plug			
DRILLERS REMARKS:			

RECEIVED
OCT 30 1974

MISSISSIPPI WATER COMMISSION

If well telescopes please sketch and show depths.

GROUND LEVEL

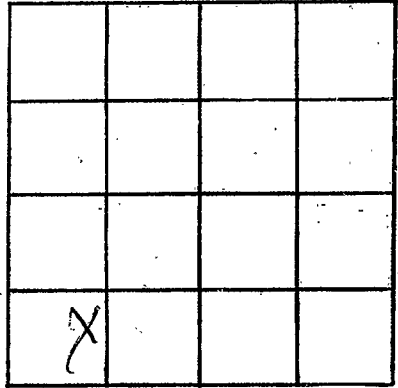

SECTION 21

Please indicate well location X.

ADDITIONAL INFORMATION

If more than one screen, show locations of each on sketch.