

PIKE
F76
3-16-74

MISSISSIPPI
BOARD OF WATER COMMISSIONERS
416 North State Street
Jackson, Mississippi 39201

RECORDED

WATER WELL DRILLERS LOG

March 16 1974 date well completed
Chester Keener firm name
Pike county well located

LANDOWNER: Washita Budget
RT3-
Tylertown, Miss
(mailing address)

WELL LOCATION:
sec. 14 T. 2 N R. 9 E
5 miles S Riceville
(distance) (direction) (nearest town)

WELL PURPOSE: Home
(home, irrigation, municipal, industrial)

- WELL COMPLETION DATA:
- (1) diameter (inches) 4"
 - (2) total depth (feet) 160
 - (3) static water level (feet) 105 below top of ground
 - (4) casing Plast. Balltown
(material) (depth)
 - (size) If telescope see back.
 - (5) screen 6' 154'
(length) (depth to top)
4" Plast
(size) (material)
 - (6) pump 1/2 Sub 12
(HP) (yield gpm)
Elect
(type power)
 - (7) electric log NO
(yes or no)
 - (organization running log)
 - (8) how well bottom plugged
woodchips

description of formations encountered	from	to
Red clay	0	16
Sand, gravel, clay	16	46
Sand & rock	46	
R. & Sand	46	98
White & blue chalk	98	135
White Sand	135	152
Small River gravel & Sand	152	160


DRILLERS REMARKS:
old 2" well had

RECEIVED
OCT 31 1974

MISSISSIPPI BOARD OF WATER COMMISSIONERS

If well telescopes please sketch and show depths.

GROUND LEVEL

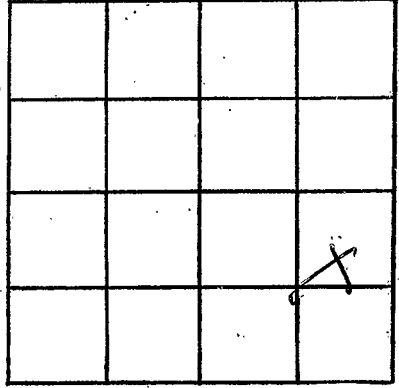

SECTION 14

Please indicate well location X.

ADDITIONAL INFORMATION

If more than one screen, show locations of each on sketch.