

PIKE
F78
10/6/74

MISSISSIPPI
BOARD OF WATER COMMISSIONERS
416 North State Street
Jackson, Mississippi 39201

CODED

WATER WELL DRILLERS LOG

6047 1974 J.T. Conington & Son Pike Co.
date well completed firm name county well located

LANDOWNER:
Everette McComb
M. C. Comb
(mailing address)

description of formations encountered	from	to
clay	0	15
loam	15	25
cherty	25	100
sand shale	110	185
rock	185	200

WELL LOCATION:
sec. 20 T 3 N R 9 E S
2 miles N of Holmanville
(distance) (direction) (nearest town)

WELL PURPOSE:
(home, irrigation, municipal, industrial)

WELL COMPLETION DATA:

- (1) diameter (inches) 4
- (2) total depth (feet) 200 ft.
- (3) static water level (feet) 4 below top of ground.
- (4) casing (material) PL (depth) 176
- (size) If telescope see back.
- (5) screen 24 (length) 176 (depth to top)
- (size) PL (material)
- (6) pump No pump at time (HP) (yield gpm)
- (type power)

CODED

(7) electric log (yes or no)

(organization running log)

(8) how well bottom plugged wood

DRILLERS REMARKS:


RECEIVED

DEC - 3 1974

MISS. BD. OF WATER

If well telescopes please sketch and show depths.

GROUND LEVEL

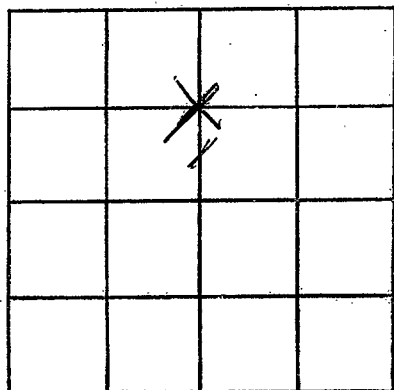

SECTION 20

Please indicate well location X.

ADDITIONAL INFORMATION

If more than one screen, show locations of each on sketch.