

PIKE
F 80
1-18-74

MISSISSIPPI
BOARD OF WATER COMMISSIONERS
416 North State Street
Jackson, Mississippi 39201
CODED

WATER WELL DRILLERS LOG

Jan 18 1974 Chester Keener Pike
date well completed firm name county well located

LANDOWNER: Seb Cas
Rt 3, Hylentown
(mailing address)
WELL LOCATION:
sec. 11 T 3 N R. 9 E ¹³⁰
3 miles N-E of Homesville
(distance) (direction) (nearest town)

WELL PURPOSE: farm
(home, irrigation, municipal, industrial)

WELL COMPLETION DATA:
(1) diameter (inches) 4"
(2) total depth (feet) 157
(3) static water level (feet) 115 ^{below} _{above} top of ground.
(4) casing Plast Bottom
(material) (depth)
 if telescope see back,
(size)
(5) screen 6 151
(length) (depth to top)
4" Plast
(size) (material)
(6) pump 1/2 Gal 12
(HP) (yield gpm)
Elect
(type power)
(7) electric log no
(yes or no)


(organization running log)

(8) how well bottom plugged
wooden plug
DRILLERS REMARKS:
New house.

description of formations encountered	from	to
Red clay	0	19
Sand & gravel	19	52
Blue & white chalk	52	105
fine sand	105	130
coarse sand	130	157
CODED		
RECEIVED		
FEB 12 1975		
MISS. BD. OF WATER COMMISSIONERS		

If well telescopes please sketch and show depths.

GROUND LEVEL

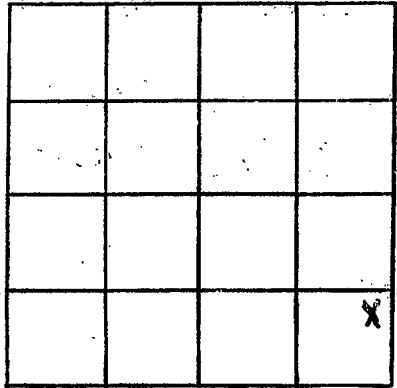

SECTION 11

Please indicate well location X.

ADDITIONAL INFORMATION

If more than one screen, show locations of each on sketch.