

Pike
 F20 F81
 6-20-79

MISSISSIPPI
 BOARD OF WATER COMMISSIONERS
 416 North State Street
 Jackson, Mississippi 39201

WATER WELL DRILLERS LOG

CODED

June 20 1974 Chatterbeens Pike
 (date well completed) (firm name) (county well located)

LANDOWNER: Telle Martin

description of formations encountered

from to

R-2

Red clay

0 12

M. Cant

Red sand +

12-28

(mailing address)

Chalk

28 74

WELL LOCATION:

Coarse sand +

74 90

sec. 21 T 3 N R 9 E

Pea Gravel

CODED

in Hainesville
 (distance) (direction) (nearest town)

WELL PURPOSE: Dairies
 (home, irrigation, municipal, industrial)

WELL COMPLETION DATA:

- (1) diameter (inches) 4"
- (2) total depth (feet) 90
- (3) static water level (feet) 12 below top of ground.

- (4) casing Plast ballinx
 (material) (depth)

(size) If telescope see back.

- (5) screen 6' 8 1/2'
 (length) (depth to top)

- (6) pump Plast
 (size) (material)

- (6) pump byones
 (HP) (yield gpm)

(type power)

- (7) electric log NO
 (yes or no)

(organization running log)

- (8) how well bottom plugged
 woodchip


DRILLERS REMARKS:
 old well had

RECEIVED

FEB 26 1975

If well telescopes please sketch and show depths.

GROUND LEVEL

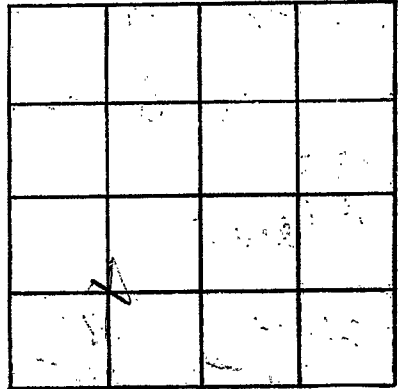

SECTION 21

Please indicate well location X.

ADDITIONAL INFORMATION

A series of horizontal lines for writing additional information.

If more than one screen, show locations of each on sketch.