

MISSISSIPPI DEPARTMENT OF NATURAL RESOURCES

Bureau of Land and Water Resources

Southport Mall

P.O. Box 10631

Jackson, Mississippi 39209

WATER WELL DRILLERS LOG

CODED

PIKE
F 83
3-12-81

Griner Drilling Service, Inc.

Pike

date well completed

firm name

county well located

LANDOWNER:

Mobil Oil Exploration
P.O. Box 2252
Houston, Texas 77001
(mailing address)

description of formations encountered

from

to

clay

0 10

gravel

10 84

sand, pea gravel

84 126

streaked

126 147

chalk sand

147 292

WELL LOCATION: 563' N + 636' E

sec. 3, 30 N R. 9 E of
Boque chitto sw/co
river (nearest town)

WELL PURPOSE: oil field
(home, irrigation, municipal, industrial)

WELL COMPLETION DATA:

- (1) diameter (inches) 4"
- (2) total depth (feet) 252'
- (3) static water level (feet) 40' (below/above top of ground)
- (4) casing steel, 252' (material), (depth)
4" (size) if telescope see back.
- (5) screen 42', 210' (length), (depth to top)
4" (size), perforated (material)
- (6) pump — (HP), 80 then (yield gpm)
AC (type power), back to 60 gpm
- (7) electric log — (yes or no) poor well
not much
yield
- (8) how well bottom plugged orange

DRILLERS REMARKS:


DEPT. OF NATURAL RESOURCES
BUREAU OF LAND & WATER RESOURCES

MAR 31 1981

RECEIVED

If well telescopes please sketch and show depths.

GROUND LEVEL

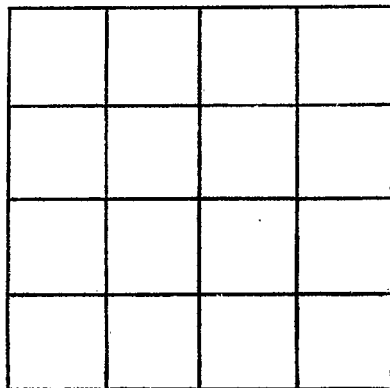

SECTION _____

Please indicate well location X.

ADDITIONAL INFORMATION

If more than one screen, show locations of each on sketch.