

MISSISSIPPI DEPARTMENT OF NATURAL RESOURCES

Bureau of Land and Water Resources

Southport Mall

P.O. Box 10631

Jackson, Mississippi 39209

WATER WELL DRILLERS LOG

**CODED**

*Griner Drilling Service, Inc.*

*Pike*

*PIKE*  
*F 84*  
  
*3-23-81*

*3-23-81* date well completed      *Griner Drilling Service, Inc.* firm name      *Pike* county well located

LANDOWNER:  
*Mobil Oil Exploration*  
*P.O. Box 2252*  
*Houston, Texas 77001*  
(mailing address)

description of formations encountered	from	to
<i>clay</i>	<i>0</i>	<i>10</i>
<i>gravel</i>	<i>10</i>	<i>84</i>
<i>sand, pea gravel</i>	<i>84</i>	<i>126</i>
<i>streaked</i>	<i>126</i>	<i>147</i>
<i>chalk</i>	<i>147</i>	<i>252</i>
<i>streaked</i>	<i>252</i>	<i>473</i>
<i>streaked, sand</i>	<i>473</i>	<i>546</i>

WELL LOCATION: *563' N 4636' E*  
*No. 3* Sec. *3* T. *30* N. R. *9* E. of  
*Clyde* *Fitzgerald* *Near Bogue Chitto*  
*River on May 98*  
Distance (miles)      Direction (h)      Address (town)

WELL PURPOSE: *oil field supply*  
(home, irrigation, municipal, industrial)

WELL COMPLETION DATA:  
*2nd* (1) diameter (inches) *4"*  
*water* (2) total depth (feet) *546'*  
*OM* (3) static water level (feet) *150' below*  
*top of ground.*  
(4) casing *steel*, *546'*  
(material) (depth)  
*4"*  
(size) if telescope see back.  
(5) screen *42'*, *504'*  
(length) (depth to top)  
*4"*, *perforated*  
(size) (material)  
(6) pump *—*, *35*  
(HP) (yield gpm)  
*AC*  
(type power)  
(7) electric log *—*  
(yes or no)  
(organization running log)  
(8) how well bottom plugged *orange*  
*peel*

**CODED**

DEPT. OF NATURAL RESOURCES  
BUREAU OF LAND & WATER RESOURCES


APR - 3 1981

**RECEIVED**

DRILLERS REMARKS:

If well telescopes please sketch and show depths.

GROUND LEVEL

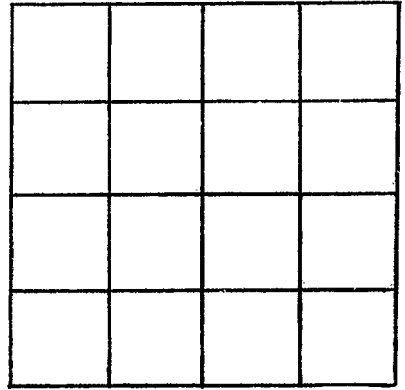

SECTION \_\_\_\_\_

Please indicate well location X.

ADDITIONAL INFORMATION

If more than one screen, show locations of each on sketch.