

MISSISSIPPI DEPARTMENT OF NATURAL RESOURCES

Bureau of Land and Water Resources

Southport Mall

P.O. Box 10631

Jackson, Mississippi 39209

WATER WELL DRILLERS LOG

CODED

| |
|---------|
| F85 |
| PIKE |
| 5-11-84 |

5-11
date well completed

1984 *F. J. Smallwell Land*
firm name

Pike
county well located

LANDOWNER: *Ernest McCarlie*
R.B. McCarlie, Jr.
(mailing address)

| description of formations encountered | from | to |
|---------------------------------------|------------|------------|
| <i>Red clay</i> | <i>0</i> | <i>20</i> |
| <i>Red sand</i> | <i>20</i> | <i>60</i> |
| <i>White clay</i> | <i>60</i> | <i>150</i> |
| <i>Coarse sand & gravel</i> | <i>150</i> | <i>179</i> |

WELL LOCATION:
sec. *20* T. *3* N. R. *9* E
8 miles *E* of *McCarlie*
(distance) (direction) (nearest town)

WELL PURPOSE: *Home*
(home, irrigation, municipal, industrial)

- WELL COMPLETION DATA:
- (1) diameter (inches) *4*
 - (2) total depth (feet) *179*
 - (3) static water level (feet) *30* below above top of ground.
 - (4) casing *PVC, 169,*
(material) (depth)
4 if telescope see back.
(size)
 - (5) screen *10, 169*
(length) (depth to top)
4, PVC
(size) (material)
 - (6) pump *1, 25*
(HP) (yield gpm)
Electric
(type power)
 - (7) electric log *No*
(yes or no)

(organization running log)
 - (8) how well bottom plugged *Sand fill*

DEPT. OF NATURAL RESOURCES
BUREAU OF LAND & WATER RESOURCES


JUN 15 1984

RECEIVED

DRILLERS REMARKS:

If well telescopes please
sketch and show depths.

GROUND LEVEL

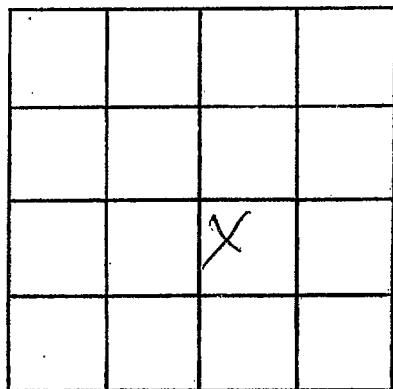

SECTION 20

Please indicate well location X.

ADDITIONAL INFORMATION

If more than one screen,
show locations of each on sketch.