

MISSISSIPPI DEPARTMENT OF NATURAL RESOURCES

Bureau of Land and Water Resources

Southport Mall

P.O. Box 10631

Jackson, Mississippi 39209

WATER WELL DRILLERS LOG

TOM GRIFFITH

PLUMBING & WELL SERVICE, INC.

320 WYSON AVE.

COLUMBIA, MS 39429

CODED

Pike Co. MS
county well located

Pike
E86
6/25/84

6-25-84
date well completed

LANDOWNER: Murco Drilling Co.

description of formations encountered

from

to

1908 Beck Building

Top soil

0' 5'

Shreveport, La 71101

Gravel

5' 220'

(mailing address)

WELL LOCATION:

sec. 35 T 3 (N) S R 9 (E) ?
10 miles E of Shreveport
(distance) (direction) (nearest town)

WELL PURPOSE: oil field location
(home, irrigation, municipal, industrial)

CODED

WELL COMPLETION DATA:

- (1) diameter (inches) 3"
- (2) total depth (feet) 220'
- (3) static water level (feet) 10' below top of ground.
- (4) casing steel, 180',
(material) (depth)
3" if telescope see back.
(size)
- (5) screen 40', 180'
(length) (depth to top)
3", slotted steel
(size) (material)
- (6) pump air lift
(HP) (yield gpm)
diesel
(type power)
- (7) electric log NO
(yes or no)
N/A
(organization running log)
- (8) how well bottom plugged welded

DRILLERS REMARKS:


MISSISSIPPI DEPARTMENT OF NATURAL RESOURCES
BUREAU OF LAND & WATER RESOURCES

AUG 7 1984

RECEIVED

If well telescopes please sketch and show depths.

GROUND LEVEL

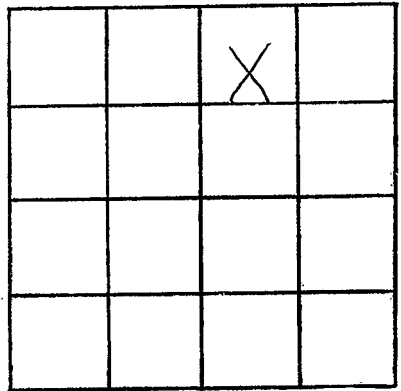

SECTION 35

Please indicate well location X.

ADDITIONAL INFORMATION

If more than one screen, show locations of each on sketch.