

MISSISSIPPI DEPARTMENT OF NATURAL RESOURCES

Bureau of Land and Water Resources

Southport Mall

P.O. Box 10631

Jackson, Mississippi 39209

WATER WELL DRILLERS LOG

CODED

Griner Drilling Service, Inc.

Pike

PIKE
F 87

11-6-84
date well completed

Griner Drilling Service, Inc.
firm name

Pike
county well located

LANDOWNER:
Helmerich and Payne
P.O. Box 6173
Pearl, Ms. 39208
(mailing address)

description of formations encountered

from to

gravel, clay 0 29

clay 29 35

gravel CODED 35 240

clay 240 252

WELL LOCATION: 832' N + 2186' W
sec. 5 T. 30 N R. 9 E S. 10 W
Shell Oil Co. No. 1 May Unit Homestead
(distance) (direction) (nearest town)

WELL PURPOSE: oil field supply
(home, irrigation, municipal, industrial)

WELL COMPLETION DATA:

- (1) diameter (inches) 4"
- (2) total depth (feet) 252'
- (3) static water level (feet) 60' below top of ground.
- (4) casing steel 210' (material), (depth)
4" (size) if telescope see back.
- (5) screen 42' 168' (length), (depth to top)
4" perforated (size), (material)
- (6) pump — 75 (HP), (yield gpm)
AC (type power)
- (7) electric log (yes or no)

(organization running log)

- (8) how well bottom plugged orange peel

DEPT. OF NATURAL RESOURCES
BUREAU OF LAND & WATER RESOURCES


NOV 16 1984

DRILLERS REMARKS:

RECEIVED

If well telescopes please
sketch and show depths.

GROUND LEVEL

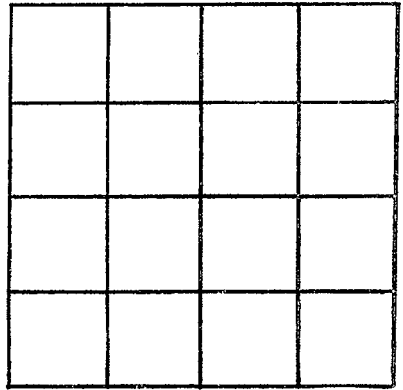

SECTION _____

Please indicate well location X.

ADDITIONAL INFORMATION

If more than one screen,
show locations of each on sketch.