

F 89  
 Pike  
 8-21-85

MISSISSIPPI  
 BOARD OF WATER COMMISSIONERS  
 416 North State Street  
 Jackson, Mississippi 39201

CODED

WATER WELL DRILLERS LOG

Griner Drilling  
 Service, INC.

Pike

date well completed

firm name

county well located

LANDOWNER:

Marion Drilling Co.  
 P.O. Box 3027  
 MOBILE, Alabama 36652  
 (mailing address)

description of formations  
 encountered

from

to

sand, gravel 0 85  
 streaked 85 120

WELL LOCATION: 2304' N + 2207' E

sec. 19 T 3 N R 9 E of  
 No. 1 E.M. Holmes miles Holmesville  
 19-11 (distance) (direction) (nearest town)

sand, pea gravel CODED 120 240

WELL PURPOSE: Oilfield supply  
 (home, irrigation, municipal, industrial)

WELL COMPLETION DATA:

- (1) diameter (inches) 3"
- (2) total depth (feet) 240'
- (3) static water level (feet) 80 <sup>below</sup> <sub>above</sub> top of ground.
- (4) casing steel, 240'  
 (material) (depth)  
3"  
 (size) If telescope see back.
- (5) screen 42', 198'  
 (length) (depth to top)  
3", perforated  
 (size) (material)
- (6) pump 70  
 (HP) (yield gpm)  
AC  
 (type power)
- (7) electric log (yes or no)

(organization running log)

- (8) how well bottom plugged orange  
peel


DRILLERS REMARKS:

RECEIVED  
 SEP 23 1985

Department of Natural Resources  
 Bureau of Land & Water Resources

If well telescopes please sketch and show depths.

GROUND LEVEL

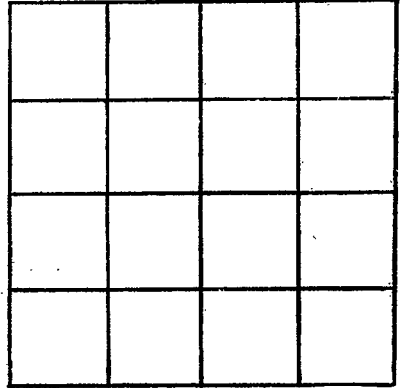

SECTION \_\_\_\_\_

Please indicate well location X.

ADDITIONAL INFORMATION

If more than one screen, show locations of each on sketch.