

MISSISSIPPI
BOARD OF WATER COMMISSIONERS
416 North State Street
Jackson, Mississippi 39201

CODED

WATER WELL DRILLERS LOG

Pike
F 90
8-24-71

24 Aug. 1971 71 SFF Waterwell Pike
date well completed firm name county well located

LANDOWNER:
Dave Tedman
McComb
(mailing address)

description of formations encountered	from	to
Clay	0	25
Chalk	25	40
sand Chalk	125	75
Sand	75	113

WELL LOCATION:
sec. 33 T. 3 N. R. 9 E
8 miles East of McComb
(distance) (direction) (nearest town)

WELL PURPOSE:
(home, irrigation, municipal, industrial)

- WELL COMPLETION DATA:
- (1) diameter (inches) 4
 - (2) total depth (feet) 143
 - (3) static water level (feet) 75 below above top of ground.
 - (4) casing PI 69,
(material) (depth)
(size) if telescope see back.
 - (5) screen 6 69
(length) (depth to top)
4 PI
(size) (material)
 - (6) pump 5 8
(HP) (yield gpm)
elect
(type power)
 - (7) electric log (yes or no)

CODED

OCT 10 1971


(organization running log)
(8) how well bottom plugged wool

MISS. BD. OF
WATER COMM.

DRILLERS REMARKS:

If well telescopes please sketch and show depths.

GROUND LEVEL

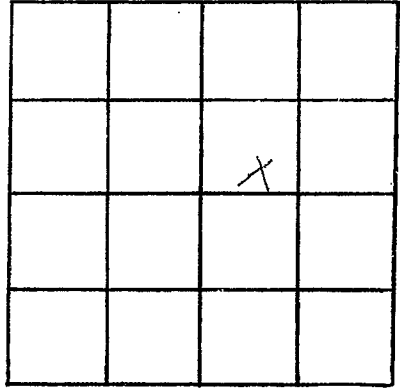

SECTION 33

Please indicate well location X.

ADDITIONAL INFORMATION

Lined area for additional information.

If more than one screen, show locations of each on sketch.