

Pike
 COUNTY WELL LOCATED
2-26-04
 WELL NUMBER _____ CODED _____
 DATE WELL COMPLETED
2-26-04

MISSISSIPPI DEPARTMENT OF ENVIRONMENTAL QUALITY

Office of Land and Water Resources

P. O. Box 10631
 Jackson, MS 39289-0631
 WATER WELL DRILLERS LOG

PERMIT NUMBER _____
 NAME OF DRILLING FIRM
Fitzgerald Well Service

NAME & MAILING ADDRESS OF LANDOWNER
Ron Rushing
Heights Rd McComb, MS
 Latitude: _____
 Longitude: _____
 WELL LOCATION: SEC 18 TOWNSHIP 3 RANGE 9
 DISTANCE 6 Miles DIRECTION East of NEAREST TOWN McComb
 OTHER LANDMARK _____
 WELL PURPOSE Home Irrigation, Municipal, Industrial, Fish Pond, etc.

PUMP DATA
 PUMP TYPE (Circle One):
 Submersible, Turbine, Jet, Flowing Well,
 Other (Describe) _____
 POWER TYPE (Circle One):
 Electric, Tractor, Diesel, Gasoline, Butane,
 Other (Describe) _____ H/P _____
 DESCRIPTION OF FORMATIONS ENCOUNTERED FROM TO

| | | |
|---------------|-----|-----|
| clay | 0 | 15 |
| sand | 15 | 60 |
| sand & gravel | 60 | 80 |
| clay | 80 | 90 |
| sand | 90 | 110 |
| course sand | 110 | 126 |

 RECEIVED
 MAR 03 2004
 BY: OI WFR
 Top of Lap Pipe or Reduction in Casing
 FEET _____ IF TELESCOPED OR MORE THAN ONE SCREEN: USE BACK PAGE

WELL DATA
 Well Depth 126' Casing Diameter (In.) 4" Casing Length (Ft.) 110'
 Type of Casing PVC Hole Depth 126' Depth to Static Water Level 77'
 TYPE OF COMPLETION: (Circle One or More):
 Gravel Packed, Underreamed, Telescoped,
 Natural Development, Open Hole, Other
 (Describe) _____
 WELL GROUTED TO A DEPTH OF 10 FEET
 Type Grout (circle one): Cement, Bentonite, or Mix

SCREEN DATA
 Diameter - Inches 4" Length - Feet 10' Slot Size - Inches .012
 Screen Type PVC Depth to Bottom - Feet 126'

I certify that the well was drilled, constructed and completed in accordance with all applicable Requirements of the Mississippi Department of Environmental Quality and/or the Mississippi Department of Health regulations and state laws.


Bevel & Fitzgerald 029
 Signature of Licensed Driller and License No.

2-26-04
 Date

Additional Information Required On Back

If well telescopes please sketch and show depths.

GROUND LEVEL

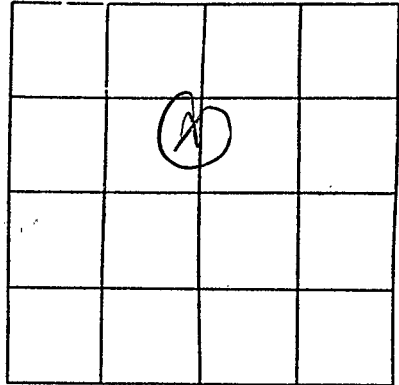

SECTION 18

Please indicate well location X.

| | | | |
|---------------------|---------------|---------------|-----|
| Pump Capacity (GPM) | No. of Stages | Setting Depth | |
| 12 | 8 | 110' | FT. |

PUMP TEST

Well yielded _____ GPM with
 a drawdown of _____ ft.
 after _____ hours of pumping

LOG DATA

TYPE OF LOG RUN (Circle One): No Log Run, Electric, Gamma Ray, Density, Sonic, Neutron, Other (Describe) _____

Name of Organization Running Log _____

GEOLOGIC DATA (Office Use Only)

| | | | |
|---------------|---------------|----------------|--------------|
| Surface Elev. | Geologic Unit | Unit Thickness | Depth to Top |
| Subs. SWL | Date | Analysis | Aquifer Test |

Driller's Remarks

If more than one screen, show location of each on sketch.