_	state w	en Keport		
County: Pike	P	art 1	For Office Use Only:	
	Mississippi Departmen	t of Environmental Quality	Aquifer:	
Permit #:GRENN_WATER_WELL &		nd Water Resources	Well #:F168	
Driller: SUPPLY, INC.	1 ! !	lox 10631		
Date drilling completed: 5-29-13		IS 39289-0631	L. S. Elevation:	
Date drinning completion:		961-5210 1-6038 (fov)	E loc#.	
(601)354-6938 (fax) E-log#:				
State Law requires that this rep	ort be prepared by the	driller in detail and filed w	ith the Department within	
30 days of completion of drilling	of the well.			
Well Owner Informa	ation	Well	Location	
Owner Name Greg Knight Latitu		Latitude: 31 · 12.552	" Longitude: 90° 18:318"	
Mailing Address: P.O. Box 3	4.1	Method of Lat/Long (circle on		
		USGS quad, Aland-held	GPS, Survey-grade GPS	
Summit MS City Sta	39664		VIWN 3N Rng 9E	
City Sta	te Zip Code	/		
Telephone No. (601) 754-38	P70	Distance SW Direction  Miles SE	Nearest Town	
			or McCome	
	Well I	Data		
Purpose of Well (circle one) Home Ind	bustial Bublic Comple	Industria Bid Cule		
		Irrigation Fish Culture	- T	
Date well drilling started: $5-29-13$ Date well drilling completed: $5-29-13$				
If flowing, method of flow regulation: Valve Other (describe)				
Static Water Level: 12 feet above or below (directe one) land surface Date measured: 5-29-13				
Method of Measurement (circle one) steel tape electric tape air line other:				
Hole depth: 78 Well depth: 77 Well grouted to a depth of 10 feet				
Type of grout (circle one): Cement	Bentonite Mix			
Casing length: 67 feet Casin	ng diameter: 4	inches Type of casing:	Pre	
Screen length: 10 feet Scre	en diameter: 4	inches Type of screen:	PVC	
Screen slot size: 1010 inches	Setting depth: From	/ ~	7 feet	
Type of completion (circle all applicable): Gravel packet Underreamed Telescoped Open hole Natural Development				
	Other (describe):			
Top of lap pipe or reduction in casing:feet. If telescoped or more than one screen, describe on back of page				
Logs run (circle all applicable): No log run Electric Gamma Ray Density Sonic Neutron Other:			Other:	
Name of organization running log(s):				
I certify that the well was drilled, constructed, and completed in accordance with all applicable requirements of the Mississippi				
Department of Environmental Quality and/or the Mississippi Department of Health regulations and state laws.				
GRENN WATER WELL & SUPPL		er encent of treatm leaminous	and state taws.	
	-0000664	Ra 111	9 Doubles	
Print Name of Water Well Contractor and	License No.	Signature of	Water Well Contractor	


Signature of Water Well Contractor

. If well telescopes please sketch below and show depths.

	٠	
•	V	

Description of Formations Encountered	From	То
Sand gavel & sand	6	14
Con al diameter		
yravel & sana	14	18
	<del></del>	
	<del>                                     </del>	

If more than one screen, show location of each on sketch

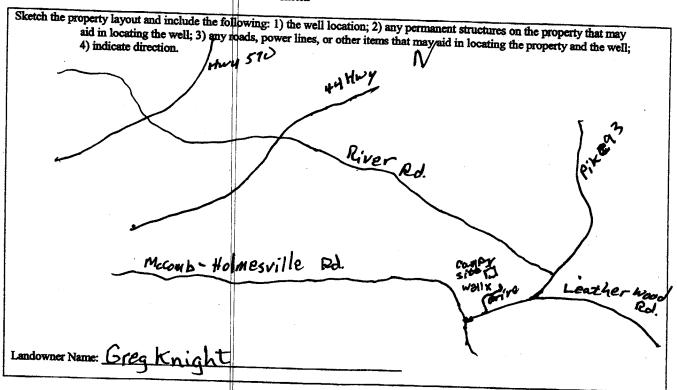

Brian WE Clare Well Contractor 664

RECEIVED

JUN 1 9 2013

BY: OLWA

## STATE WELL REPORT

## County: Driller: GRENN WATER WELL & SUPPLY, Date completed:

Part 2 Pump Installer's Completion Report Mississippi Department of Environmental Quality Office of Land and Water Resources

P.O. Box 10631 Jackson, MS 39289-0631 (601)961-5210 (601)354-6938 (fax)

For Office Use Only:				
Aquifer:				
Well #:	F168			
Elevation:				

This report should be prepared by the pump installer in de installation of pump.	tail and filed with the Department within 30 days of the		
Well Owner Information	Well Location		
Owner Name: Grey Knight	Latitude: 31 0 12 532 Longitude: 90 18 318		
Mailing Address: P.O. Box JU	Method of Lat/Long (circle one): Conventional Survey,		
	USGS quad Hand-held GPS, Survey-grade GPS		
Summif MS 39664 City State Zip Code	NE 1/4 NW 1/4 Sec 21 Twn 3 N Rng 9E		
!	Distance Direction Nearest Town		
Telephone No. (601) 754-3879	9 Miles SE of McComb		
Pump Type			
Circle one	Power Type Circle one		
Air Lift Jet Submersible	Diesel Engine Gasoline Engine Natural Gas		
Bucket Piston Turbine	Electric Motor Hand Tractor PTO		
Centrifugal Rotary Flowing Well	Windmill Other (specify):		
Other (specify):	Horse Power Rating of Motor:		
Date Pump Installed: 5/29/13	Setting Depth: 30 feet		
Rated Pump Capacity: Gallons Per Minute	Number of Stages: 9		
Pump Test Data	Method of Measuring Water Level		
Date Well Tested: 5/29/13	Circle one		
Static Water Level (A):   2 Feet Below Land Surface	Air Line Electric Measuring Line Steel Tape		
Pumping Water Level (B): 14 Feet Below Land Surface	Other (specify):		
Drawdown [(B) - (A)]: Z Feet Below Land Surface	For flowing well, measured shut in head:feet		
Test Pumping Rate: Gallons Per Minute	Well yielded 14 GPM with a drawdown of		
Duration of Pump Test (minimum 4 hours): hours			
I HERERY CERTIEV 4.4.4.			

that the above statements are true to the best of my knowledge. WILLIAM L. HARDIN, V, UNR-00000802 Print Name of Pump Installer and License No. (if applicable) Signature of Pump Installer

RECEIVED
JUN 1 9 2013
BY: OLWA