

F200 CODEL
10-8-65

WATER WELL DRILLERS LOG

Date: 10-8, 1965, Driller: J. T. Coington Beek County Pike
(Name)

(1) Owner of Land: Eunone Jackson
(Name)
McComb Mrs
(Address)

(2) Location: 1/4, 1/4, Sec. 16 T. 3 R. 9
10 miles East of McComb
(distance) (direction) (Nearest Town)

(3) Topography: Hilly
(Hilly) (Flat) (Level)

(4) Purpose of Well: Domestic
(Domestic Irrigation
Municipal, Industrial, Other)

Description & Color of Materials Sand, Clay, Red Clay, Shell, etc.	Thick- ness Feet	Depth Feet
<u>Sandy Clay</u>	<u>60</u>	<u>60</u>
<u>Rocks</u>	<u>60</u>	<u>120</u>
<u>SANDS</u>	<u>20</u>	<u>140</u>
<u>not coded.</u>		

Information upon completion of well:

(1) Diameter 4" inches.


(2) Total Depth 140' feet.

(3) Water Level 110' feet below top of ground.

(4) Cased to 140', Size 4"

(5) Screen: Size 4", Length 6'

(6) Were any formations sealed against pollution?
no ✓

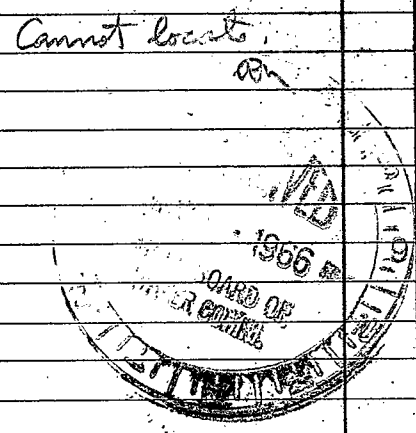

If YES depth of formation _____

Why _____

Drillers Remarks: _____

(Use Back Side)

Well No.

