

Pike  
 F 2001  
 10-30-75

MISSISSIPPI  
 BOARD OF WATER COMMISSIONERS  
 416 North State Street  
 Jackson, Mississippi 39201

WATER WELL DRILLERS LOG

Oct 30 1975 Revere Well Service Pike  
 date well completed firm name county well located

LANDOWNER:  
Sammons Graham  
RT 3 Tutuon  
 (mailing address)


description of formations encountered	from	to
Clay	0	20
pink Chalk	20	50
light green sand	50	75
chobby	75	105
sand	105	139

WELL LOCATION:  
 sec. 11 T. 3 N. R. 9 E.  
4 miles South of Prichard  
 (distance) (direction) (nearest town)

WELL PURPOSE: Home  
 (home, irrigation, municipal, industrial)

- WELL COMPLETION DATA:
- (1) diameter (inches) 4"
  - (2) total depth (feet) 139
  - (3) static water level (feet) 104 below top of ground.
  - (4) casing plastic (material) bottom (depth)
  - (5) screen 6' (length) 133 (depth to top)
  - (6) pump 1/2 (HP) 10 (yield gpm)
  - (7) electric log no (yes or no)
  - (8) how well bottom plugged wooden plug


DRILLERS REMARKS:  
old plastic well  
hit by lightning

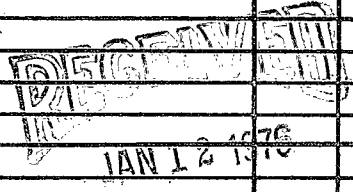

MISS. Bd. of WATER COMM.

If well telescopes please sketch and show depths.

GROUND LEVEL

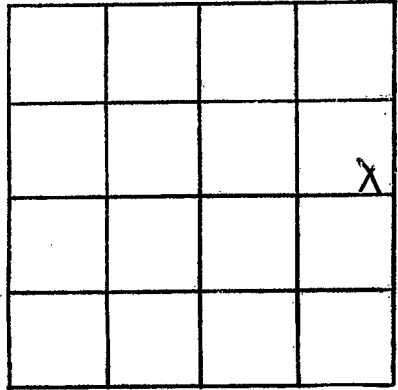

SECTION 11

Please indicate well location X.

ADDITIONAL INFORMATION

If more than one screen,  
show locations of each on sketch.