

Pike
 F 2002
 12-15-75

MISSISSIPPI
 BOARD OF WATER COMMISSIONERS
 416 North State Street
 Jackson, Mississippi 39201

WATER WELL DRILLERS LOG

12-15 1975 Fitzgerald Law Pike
 date well completed firm name county well located

LANDOWNER:
Jimmy Tucker
R.R. McComb, Miss.
 (mailing address)

description of formations encountered	from	to
<u>Red clay</u>	<u>0</u>	<u>15</u>
<u>White clay & fine sand</u>	<u>15</u>	<u>115</u>
<u>Coarse sand & gravel</u>	<u>115</u>	<u>130</u>

WELL LOCATION:
 sec. 20 T. 3 N. R. 9 E
20 S 9 W
9 miles E of McComb
 (distance) (direction) (nearest town)

WELL PURPOSE: Home
 (home, irrigation, municipal, industrial)


- WELL COMPLETION DATA:
- (1) diameter (inches) 4
 - (2) total depth (feet) 130
 - (3) static water level (feet) 35 below top of ground.
 - (4) casing PVC 120
 (material) (depth)
4 If telescope see-back.
 (size)
 - (5) screen 10 120
 (length) (depth to top)
4 PVC
 (size) (material)
 - (6) pump 1 25
 (HP) (yield gpm)
elec
 (type power)
 - (7) electric log no
 (yes or no)
(organization running log)
 - (8) how well bottom plugged Level floor

DRILLERS REMARKS:

FEB 4 - 1976
 MISS. Bd. OF WATER COMMISSIONERS

If well telescopes please sketch and show depths.

GROUND LEVEL

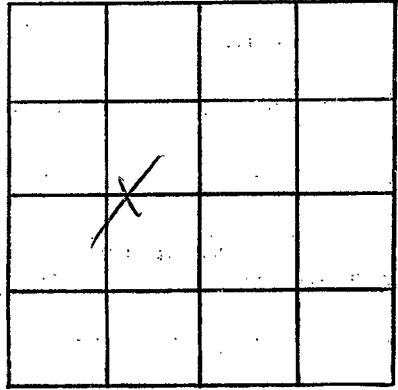

SECTION 20

Please indicate well location X.

ADDITIONAL INFORMATION

If more than one screen, show locations of each on sketch.