

Pike
 F 2004
 5-22-76

MISSISSIPPI
 BOARD OF WATER COMMISSIONERS
 416 North State Street
 Jackson, Mississippi 39201

134

WATER WELL DRILLERS LOG

May 22 1976 Peaswell & Pike
 date well completed firm name county well located

LANDOWNER:	description of formations encountered	from	to
Mr. Richard Barr Rt 2 Mc Cook (mailing address)			
	Red sand	25	70
	hard big gravel	70	90
	Red sand	90	130
	(Red) gravel	130	150
	White Chalk	150	200
	Coarse sand & small peagrand	200	220

WELL LOCATION:
 sec. 29 T 3 N R 9 E
 1 1/2 miles South Holmes
 (distance) (direction) (nearest town)

WELL PURPOSE: Water
 (home, irrigation, municipal, industrial)

WELL COMPLETION DATA:

(1) diameter (inches) 4"

(2) total depth (feet) 220

(3) static water level (feet) 145 below top of ground.

(4) casing plastic (material) bottom (depth)

1 (size) if telescope see back.

(5) screen 6" (length) 139 (depth to top)

4" (size) plastic (material)

(6) pump 3/4" Sub (HP) 1.2 (yield gpm)

elect (type power)

(7) electric log no (yes or no)

 (organization running log)

(8) how well bottom plugged
Water plug

DRILLERS REMARKS:
Drilling to make


RECEIVED

AUG 20 1976

MISSISSIPPI BOARD OF WATER COMMISSIONERS

If well telescopes please sketch and show depths.

GROUND LEVEL

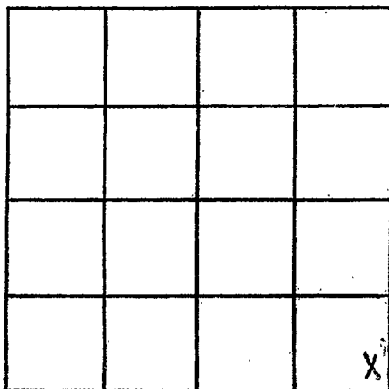

SECTION 29

Please indicate well location X.

ADDITIONAL INFORMATION

If more than one screen, show locations of each on sketch.