

Pike
 F 2000
 8/13/76

MISSISSIPPI
 BOARD OF WATER COMMISSIONERS
 416 North State Street
 Jackson, Mississippi 39201

WATER WELL DRILLERS LOG

8-73

1976 Fitzgerald Well Serv

Pike

date well completed


firm name

county well located

LANDOWNER:	description of formations encountered	from	to
Jimmy Webb - R.R. 1 in York, Miss (mailing address)	Red clay	0	20
WELL LOCATION:	Red sand	20	70
sec. 30 T 30 N R 9 E S W 8 miles E of York (distance) (direction) (nearest town)	Red gravel	70	95
WELL PURPOSE: Home (home, irrigation, municipal, industrial)	Red sand	95	110
WELL COMPLETION DATA:	Coarse sand & gravel	110	122
(1) diameter (inches) 4			
(2) total depth (feet) 122			
(3) static water level (feet) 95 below top of ground.			
(4) casing PVC 114 (material) (depth)			
4 (size) If telescope see back.			
(5) screen 8 114 (length) (depth to top)			
4 PVC (size) (material)			
(6) pump 1/2 10 (HP) (yield gpm)			
Elec (type power)			
(7) electric log No (yes or no)			
(organization running log)			
(8) how well bottom plugged Sand shell			
DRILLERS REMARKS:	<p style="text-align: center;">RECEIVED</p> <p style="text-align: center;">AUG 20 1976</p> <p style="text-align: center;">MISS. BD. OF WATER COMME</p>		

If well telescopes please sketch and show depths.

GROUND LEVEL

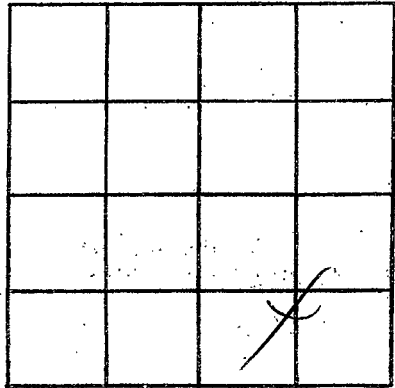

SECTION 30

Please indicate well location X.

ADDITIONAL INFORMATION

If more than one screen,
show locations of each on sketch.