

Pike
F 2010
6-8-77

MISSISSIPPI
BOARD OF WATER COMMISSIONERS
416 North State Street
Jackson, Mississippi 39201
WATER WELL DRILLERS LOG

6-8 1977 Franklin W Pike
date well completed firm name county well located

LANDOWNER:

Wentt McEntire

R.R. McEntire, Mrs.
(mailing address)

WELL LOCATION:

sec. 20 T. 3 N R. 9 E
9 miles E of McEntire
(distance) (direction) (nearest town)

WELL PURPOSE:

Home
(home, irrigation, municipal, industrial)

WELL COMPLETION DATA:

- (1) diameter (inches) 4
- (2) total depth (feet) 172
- (3) static water level (feet) 80 below above top of ground.
- (4) casing PVC 164,
(material) (depth)
4 If telescope see back.
(size)
- (5) screen 8 164
(length) (depth to top)
4 PVC
(size) (material)
- (6) pump 1 1.8
(HP) (yield gpm)
Electric
(type power)
- (7) electric log No
(yes or no)
(organization running log)
- (8) how well bottom plugged Seal Shell

description of formations encountered

from to

description of formations encountered	from	to
<u>Red clay</u>	<u>0</u>	<u>20</u>
<u>red sand</u>	<u>20</u>	<u>60</u>
<u>Blue clay</u>	<u>60</u>	<u>160</u>
<u>Cowee hole ground</u>	<u>160</u>	<u>172</u>

DRILLERS REMARKS:


RECEIVED

JUN 29 1977

MISS. BD. OF WATER COMMISSIONERS

If well telescopes please sketch and show depths.

GROUND LEVEL

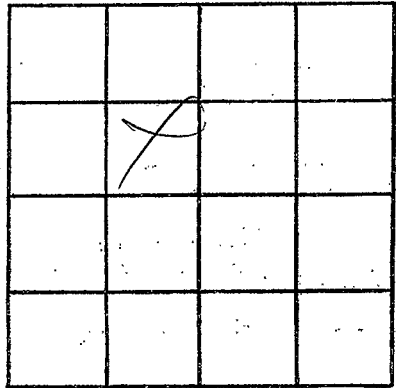

SECTION 28

Please indicate well location X.

ADDITIONAL INFORMATION

If more than one screen,
show locations of each on sketch.