

Pike
 F 2011
 8/15/77

MISSISSIPPI
 BOARD OF WATER COMMISSIONERS
 416 North State Street
 Jackson, Mississippi 39201

106

WATER WELL DRILLERS LOG

Aug 15 1977 Rever Miller Pike
 date well completed firm name county well located

LANDOWNER:
Richman Conley Jr
Rt 2 M^o Cornuk
 (mailing address)

description of formations encountered	from	to
Red clay	0	20
Chalky sand	20	60
Sand & gravel	60	90
white Chalk	90	115
Sand & fine gravel	115	138

WELL LOCATION:
 sec 30 T 3 N R 9 E
2 miles S-SW of Holmesville
 (distance) (direction) (nearest town)

WELL PURPOSE: home
 (home, irrigation, municipal, industrial)


WELL COMPLETION DATA:
 (1) diameter (inches) 4
 (2) total depth (feet) 138
 (3) static water level (feet) 95 below top of ground
 (4) casing plastic bottom
 (material) (depth)
1 if telescope see back.
 (size)
 (5) screen 6' 132'
 (length) (depth to top)
4" plastic
 (size) (material)
 (6) pump 3/4 HP 12
 (HP) (yield gpm)
split
 (type power)
 (7) electric log no
 (yes or no)
 (organization running log)

(8) how well bottom plugged
wooden plug
 DRILLERS REMARKS:

RECEIVED
 DEC 30 1977
 MISS. BD. OF WATER COMM

If well telescopes please sketch and show depths.

GROUND LEVEL

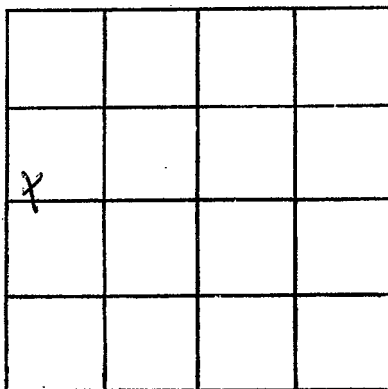

SECTION 30

Please indicate well location X.

ADDITIONAL INFORMATION

If more than one screen,
show locations of each on sketch.