

Pike
F 2012
8/23/77

MISSISSIPPI
BOARD OF WATER COMMISSIONERS
416 North State Street
Jackson, Mississippi 39201

(112)

WATER WELL DRILLERS LOG

Aug 23 1977 Reems Miller Pike
date well completed firm name county well located


LANDOWNER:	description of formations encountered	from	to
<u>John Harrison</u> <u>Box 2, W. G. Comb</u> (mailing address)			
	<u>Red sand</u>	<u>22</u>	<u>60</u>
	<u>loamy chalk</u>	<u>60</u>	<u>125</u>
	<u>sand & pebbles</u>	<u>55</u>	<u>140</u>
WELL LOCATION:			
sec. <u>2</u> T. <u>3</u> N. R. <u>9</u> E			
<u>3</u> miles <u>South</u> of <u>Price Lake</u> (distance) (direction) (nearest town)			
WELL PURPOSE: <u>home</u> (home, irrigation, municipal, industrial)			
WELL COMPLETION DATA:			
(1) diameter (inches) <u>4</u>			
(2) total depth (feet) <u>140</u>			
(3) static water level (feet) <u>60</u> below above top of ground.			
(4) casing <u>plastic bottom</u> (material) (depth)			
<u> </u> if telescope see back. (size)			
(5) screen <u>6'</u> <u>134'</u> (length) (depth to top)			
<u>4"</u> <u>plastic</u> (size) (material)			
(6) pump <u>pump not installed yet</u> (HP) (yield gpm)			
<u>electric</u> (type power)			
(7) electric log <u>no</u> (yes or no)			
<u> </u> (organization running log)			
(8) how well bottom plugged <u>wooden plug</u>			
DRILLERS REMARKS:			

RECEIVED
DEC 30 1977

MISS. BD. OF WATER COMM

If well telescopes please sketch and show depths.

GROUND LEVEL

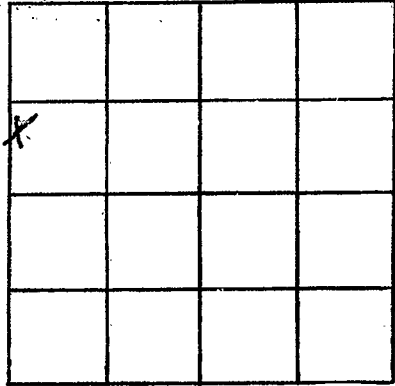

SECTION 2

Please indicate well location X.

ADDITIONAL INFORMATION

If more than one screen,
show locations of each on sketch.