

PIKE
F 2013
9/1/77

MISSISSIPPI
BOARD OF WATER COMMISSIONERS
416 North State Street
Jackson, Mississippi 39201

118

WATER WELL DRILLERS LOG

9-77 date well completed 1977 firm name *Beumiller* county well located *Pike*

LANDOWNER:
Mass Mason
Rt 1 McComb
(mailing address)

description of formations encountered	from	to
<i>Red clay</i>	<i>0</i>	<i>22</i>
<i>Red sand</i>	<i>22</i>	<i>50</i>
<i>pink chert</i>	<i>50</i>	<i>60</i>
<i>white pebbles</i>	<i>60</i>	<i>85</i>
<i>light sand</i>	<i>85</i>	<i>100</i>
<i>white chert</i>	<i>100</i>	<i>115</i>
<i>blue sand</i>	<i>115</i>	<i>130</i>

WELL LOCATION:
sec. *18* T. *3* N R. *9* E
6 miles *east* of *McComb*
(distance) (direction) (nearest town)

WELL PURPOSE: *Home*
(home, irrigation, municipal, industrial)

- WELL COMPLETION DATA:
- (1) diameter (inches) *4"*
 - (2) total depth (feet) *130*
 - (3) static water level (feet) *85* below top of ground.
 - (4) casing *4"* (material) *Bottom* (depth)
 - K* if telescope see back. (size)
 - (5) screen *5'* (length) *125'* (depth to top)
 - 4"* (size) *Plastic* (material)
 - (6) pump *3 HP* (HP) *6* (yield gpm)
 - 1/2 HP* (type power)
 - (7) electric log *No* (yes or no)

(organization running log)

(8) how well bottom plugged *wooden plug*


DRILLERS REMARKS:

RECEIVED

FEB 21 1978

If well telescopes please sketch and show depths.

GROUND LEVEL

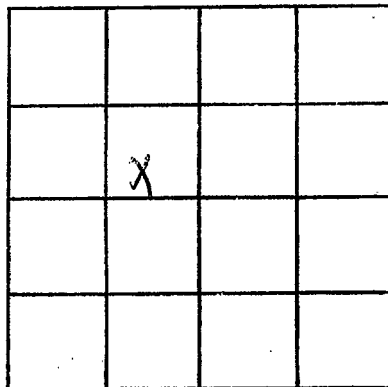

SECTION 18

Please indicate well location X.

ADDITIONAL INFORMATION

If more than one screen, show locations of each on sketch.