

PIKE
F 2014
9/13/77

MISSISSIPPI
BOARD OF WATER COMMISSIONERS
416 North State Street
Jackson, Mississippi 39201

123

WATER WELL DRILLERS LOG

9-13 1977 Reeves Well Service Pike
date well completed firm name county well located

LANDOWNER:
Hershell Jones
Pt 2 McComb
(mailing address)

description of formations encountered	from	to
<u>Clay</u>	<u>0</u>	<u>12</u>
<u>sandy clay</u>	<u>12</u>	<u>45</u>
<u>Chalk gravel</u>	<u>45</u>	<u>90</u>
<u>sand gravel</u>	<u>90</u>	<u>103</u>

WELL LOCATION:
sec. 31 T-3 N R-9 E
3 miles S-SW of Holmenville
(distance) (direction) (nearest town)

WELL PURPOSE: Rest house
(home, irrigation, municipal, industrial)


WELL COMPLETION DATA:
(1) diameter (inches) 4"
(2) total depth (feet) 103
(3) static water level (feet) 45 above top of ground.
(4) casing plastic, bottom
(material) (depth)
✓ if telescope see back.
(size)
(5) screen 5" 97'
(length) (depth to top)
4" plastic
(size) (material)
(6) pump Lyathers
(HP) (yield gpm)
shot
(type power)
(7) electric log no
(yes or no)
(organization running log)

(8) how well bottom plugged
wooden plug
DRILLERS REMARKS:

RECEIVED
FEB 21 1978

If well telescopes please sketch and show depths.

GROUND LEVEL

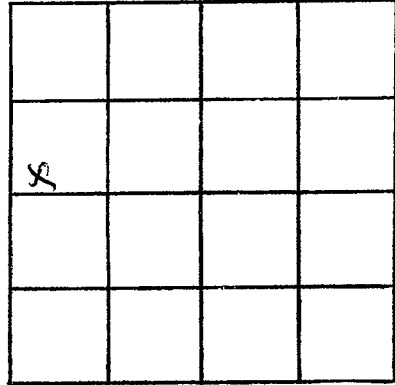

SECTION 31

Please indicate well location X.

ADDITIONAL INFORMATION

If more than one screen,
show locations of each on sketch.