

Pike
 E 2015
 9/27/77

MISSISSIPPI
 BOARD OF WATER COMMISSIONERS
 416 North State Street
 1324 Jackson, Mississippi 39201

WATER WELL DRILLERS LOG

9-27 1977 Fitzgerald Well Service Pike
 date well completed firm name county well located


LANDOWNER:	description of formations encountered	from	to
<p><u>Tommy Sauls</u> <u>RR. McComb owners</u> (mailing address)</p>	<p><u>Red Clay</u> <u>Fine sand & gravel</u> <u>Coarse sand & gravel</u></p>	<p><u>0</u> <u>20</u> <u>50</u></p>	<p><u>20</u> <u>50</u> <u>72</u></p>
<p>WELL LOCATION: sec. <u>22</u>T <u>3</u>N <u>S</u> R. <u>9</u>E <u>W</u> <u>9</u> miles <u>E</u> of <u>McComb</u> (distance) (direction) (nearest town)</p>			
<p>WELL PURPOSE: <u>Home</u> (home, irrigation, municipal, industrial)</p>			
<p>WELL COMPLETION DATA:</p> <p>(1) diameter (inches) <u>4</u></p> <p>(2) total depth (feet) <u>72</u></p> <p>(3) static water level (feet) <u>18</u> below above top of ground.</p> <p>(4) casing <u>PVC</u>, <u>64</u>, (material) (depth) <u>4</u> if telescope see back. (size)</p> <p>(5) screen <u>8</u>, <u>64</u> (length) (depth to top) <u>4</u>, <u>PVC</u> (size) (material)</p> <p>(6) pump <u>1/2</u>, <u>10</u> (HP) (yield gpm) <u>Elec</u> (type power)</p> <p>(7) electric log <u>No</u> (yes or no) (organization running log)</p> <p>(8) how well bottom plugged <u>level floor</u></p>			
<p>DRILLERS REMARKS:</p>			

RECEIVED
 OCT 31 1977

MISS. BD. OF WATER COM.

If well telescopes please sketch and show depths.

GROUND LEVEL

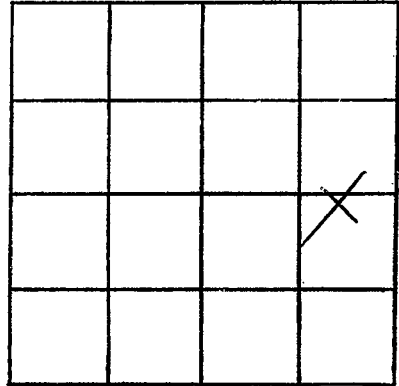

SECTION 22

Please indicate well location X.

ADDITIONAL INFORMATION

If more than one screen,
show locations of each on sketch.