

Pike  
 F 2016  
 12/20/77

MISSISSIPPI  
 BOARD OF WATER COMMISSIONERS  
 416 North State Street  
 Jackson, Mississippi 39201

WATER WELL DRILLERS LOG

12-20 1977 Fitzgerald Wells Pike  
 date well completed firm name county well located

LANDOWNER:  
Will Leahy  
R.R. m 66 -  
 (mailing address)

description of formations encountered	from	to
<u>Red clay</u>	<u>0</u>	<u>20</u>
<u>Red sand</u>	<u>20</u>	<u>115</u>
<u>Coarse sand &amp; gravel</u>	<u>115</u>	<u>146</u>

WELL LOCATION:  
 sec. 9 T. 3 N. R. 9 E  
10 miles E of m 66  
 (distance) (direction) (nearest town)

WELL PURPOSE: Home  
 (home, irrigation, municipal, industrial)

- WELL COMPLETION DATA:
- (1) diameter (inches) 4
  - (2) total depth (feet) 140
  - (3) static water level (feet) 116 below top of ground.
  - (4) casing M/C, 132  
 (material) (depth)  
4 if telescope see back.  
 (size)
  - (5) screen 8, 132  
 (length) (depth to top)  
4, M/C  
 (size) (material)
  - (6) pump 1/2, 10  
 (HP) (yield gpm)  
Electric  
 (type power)
  - (7) electric log no  
 (yes or no)  
 (organization running log)
  - (8) how well bottom plugged Sealed


RECEIVED  
 DEC 28 1977

DRILLERS REMARKS:

MISS. BD. OF WATER COMM.

If well telescopes please sketch and show depths.

GROUND LEVEL

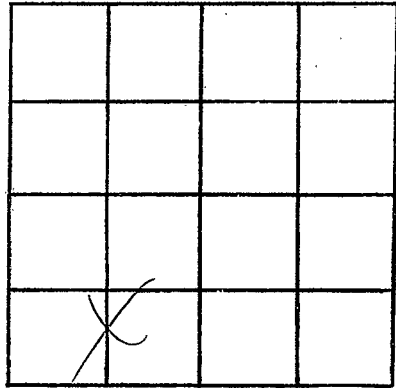

SECTION 9

Please indicate well location X.

ADDITIONAL INFORMATION

If more than one screen,  
show locations of each on sketch.