

PIKE  
 2017 F  
 1-12-78

MISSISSIPPI  
 BOARD OF WATER COMMISSIONERS  
 416 North State Street  
 Jackson, Mississippi 39201

WATER WELL DRILLERS LOG

Jan 12 - 1978 Rever Miller Pike  
 date well completed firm name county well located

LANDOWNER:	description of formations encountered	from	to
<u>Aug Washington</u>			
<u>Panerson Job (F-11A)</u> (mailing address)	<u>sand + gravel</u>	<u>12</u>	<u>50</u>
	<u>pink chalk</u>	<u>50</u>	<u>76</u>
	<u>sand</u>	<u>76</u>	<u>85</u>
	<u>blue chalk</u>	<u>85</u>	<u>150</u>
	<u>Coarse sand</u>	<u>150</u>	<u>195</u>

WELL LOCATION:  
 sec 11 T 3 N R 9 E  
3 miles NW of Holmesville  
 (distance) (direction) (nearest town)

WELL PURPOSE: home  
 (home, irrigation, municipal, industrial)


- WELL COMPLETION DATA:
- (1) diameter (inches) 4"
  - (2) total depth (feet) 195
  - (3) static water level (feet) 110 below above top of ground
  - (4) casing plastic bottom  
(material) (depth)
  - 4 if telescope see back.  
(size)
  - (5) screen 5' 180'  
(length) (depth to top)
  - 4" plastic  
(size) (material)
  - (6) pump 1/2 10  
(HP) (yield gpm)
  - split  
(type power)
  - (7) electric log no  
(yes or no)

(8) how well bottom plugged  
wooden plug  
 DRILLERS REMARKS: ✓

RECEIVED  
 MAY 11 1978

If well telescopes please sketch and show depths.

GROUND LEVEL

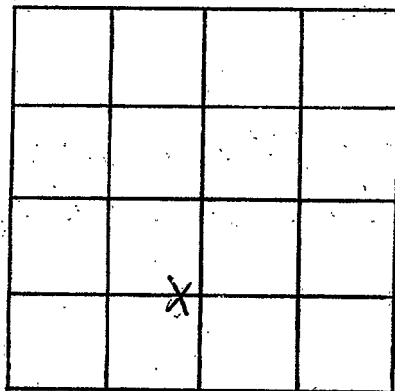

SECTION   //  

Please indicate well location X.

ADDITIONAL INFORMATION

If more than one screen,  
show locations of each on sketch.